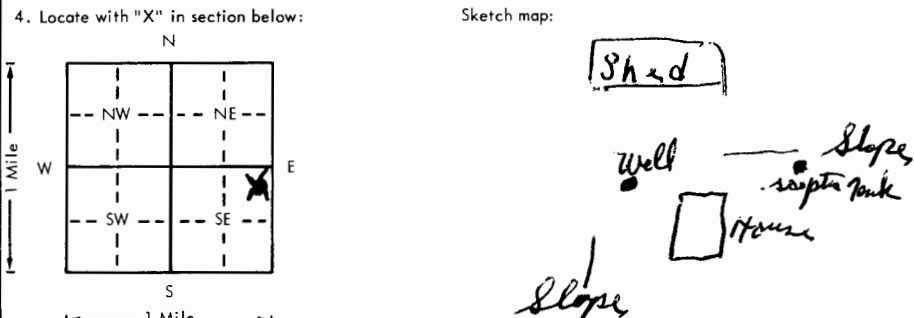


USE TYPEWRITER OR BALL POINT PEN-PRESS FIRMLY, PRINT CLEARLY.

WATER WELL RECORD
KSA 82a-1201-1215

Kansas Department of Health and Environment-Division of Environment
(Water well Contractors)
Topeka, Kansas 66620

1. Location of well: County <u>Meade</u>		Fraction <u>NE 1/4 NE 1/4 SE 1/4</u>		Section number <u>17</u>		Township number T <u>31</u> S R <u>29</u> E <u>(M)</u>																													
2. Distance and direction from nearest town or city: NE 9 1/4 N Street address of well location if in city: <u>from Meade</u>				3. Owner of well: <u>Ralph Robinson</u> R.R. or street: <u>Blair No</u> City, state, zip code: <u>67869</u>																															
4. Locate with "X" in section below: Sketch map: 				6. Bore hole dia. <u>8 3/4</u> in. Completion date <u>8-30-79</u> Well depth <u>300</u> ft.																															
5. Type and color of material				7. <input type="checkbox"/> Cable tool <input checked="" type="checkbox"/> Rotary <input type="checkbox"/> Driven <input type="checkbox"/> Dug <input type="checkbox"/> Hollow rod <input type="checkbox"/> Jetted <input type="checkbox"/> Bored <input type="checkbox"/> Reverse rotary																															
<table border="1" style="width:100%; border-collapse: collapse;"> <thead> <tr> <th>From</th> <th>To</th> </tr> </thead> <tbody> <tr><td><u>0</u></td><td><u>5</u></td></tr> <tr><td><u>6</u></td><td><u>15</u></td></tr> <tr><td><u>16</u></td><td><u>50</u></td></tr> <tr><td><u>51</u></td><td><u>70</u></td></tr> <tr><td><u>71</u></td><td><u>85</u></td></tr> <tr><td><u>86</u></td><td><u>95</u></td></tr> <tr><td><u>96</u></td><td><u>110</u></td></tr> <tr><td><u>111</u></td><td><u>130</u></td></tr> <tr><td><u>131</u></td><td><u>210</u></td></tr> <tr><td><u>211</u></td><td><u>215</u></td></tr> <tr><td><u>216</u></td><td><u>235</u></td></tr> <tr><td><u>236</u></td><td><u>300</u></td></tr> <tr><td><u>300</u></td><td></td></tr> </tbody> </table>				From	To	<u>0</u>	<u>5</u>	<u>6</u>	<u>15</u>	<u>16</u>	<u>50</u>	<u>51</u>	<u>70</u>	<u>71</u>	<u>85</u>	<u>86</u>	<u>95</u>	<u>96</u>	<u>110</u>	<u>111</u>	<u>130</u>	<u>131</u>	<u>210</u>	<u>211</u>	<u>215</u>	<u>216</u>	<u>235</u>	<u>236</u>	<u>300</u>	<u>300</u>		8. Use: <input checked="" type="checkbox"/> Domestic <input type="checkbox"/> Public supply <input type="checkbox"/> Industry <input type="checkbox"/> Irrigation <input type="checkbox"/> Air conditioning <input type="checkbox"/> Stock <input type="checkbox"/> Lawn <input type="checkbox"/> Oil field water <input type="checkbox"/> Other			
Casing: Material <u>PVC</u> Height: <u>Above</u> or below Threading: <input type="checkbox"/> Welded <input type="checkbox"/> Surface <u>72"</u> in. RMP: <input type="checkbox"/> PVC <input checked="" type="checkbox"/> Weight <u>200 PSI</u> lbs./ft. Dia. <u>5</u> in. to <u>300</u> ft. depth Wall Thickness: inches or Dia. <u>5</u> in. to <u>300</u> ft. depth gage No. <u>404</u>			
Screen: Manufacturer's name <u>Jet Stream</u> Type <u>PVC</u> Dia. <u>5"</u> Slot/gauze <u>1/16"</u> Length <u>40</u> Set between <u>260</u> ft. and <u>300</u> ft. Gravel pack? <input checked="" type="checkbox"/> Size range of material <u>1/4 X 1/4</u>			
Static water level: <u>135</u> ft. below land surface Date <u>8-29-79</u> 12. Pumping level below land surfaces: <u>138</u> ft. after <u>1 1/2</u> hrs. pumping <u>15</u> g.p.m. Estimated maximum yield <u>50</u> g.p.m.			
Water sample submitted: <u>X</u> Yes <u>X</u> No Date _____ 14. Well head completion: <input checked="" type="checkbox"/> Pitless adapter <u>12</u> inches above grade			
Well grouted? <u>Yes</u> With: <input type="checkbox"/> Neat cement <input type="checkbox"/> Bentonite <input checked="" type="checkbox"/> Concrete Depth: From <u>4</u> ft. to <u>15</u> ft.			
Nearest source of possible contamination: ft. <u>200</u> Direction <u>E</u> Type <u>script tank</u> Well disinfected upon completion? <input checked="" type="checkbox"/> Yes <input type="checkbox"/> No			
Pump: Not installed Manufacturer's name <u>Flint Walking</u> Model number <u>10BA15</u> HP <u>1</u> Volts <u>230V</u> Length of drop pipe <u>180</u> ft. capacity <u>10</u> g.p.m. Type: <input checked="" type="checkbox"/> Submersible <input type="checkbox"/> Turbine <input type="checkbox"/> Jet <input type="checkbox"/> Reciprocating <input type="checkbox"/> Centrifugal <input type="checkbox"/> Other			
Water well contractor's certification: This well was drilled under my jurisdiction and this report is true to the best of my knowledge and belief. <u>Bartel Dry</u> <u>A151</u> Business name License No. Address <u>Meade, Kans</u> Signed <u>Lib R Bartel</u> Date <u>9-1-79</u> Authorized representative			
18. Elevation:		19. Remarks:		20. Water well contractor's certification:		This well was drilled under my jurisdiction and this report is true to the best of my knowledge and belief.																													
Topography: <input type="checkbox"/> Hill <input type="checkbox"/> Slope <input checked="" type="checkbox"/> Upland <input type="checkbox"/> Valley				Business name <u>Bartel Dry</u> License No. <u>A151</u> Address <u>Meade, Kans</u> Signed <u>Lib R Bartel</u> Date <u>9-1-79</u> Authorized representative																															

Forward the white, blue and pink copies to the Department of Health and Environment

Form WWC-5

31
 29
 17 NE 1/4 SE
 1/4 1/4 1/4