


1 LOCATION OF WATER WELL: County: **Meade** Fraction $\frac{3}{4}$ **C-SW** $\frac{1}{4}$ **NW** $\frac{1}{4}$ Section Number **34** Township Number **T 31 S** Range Number **R 29 EW**

Distance and direction from nearest town or city street address of well if located within city? **From Plains go 8mi East to Missler Road then 2mi North 1 1/2mi West 1/2mi South and West into location.**

2 WATER WELL OWNER: **Jim Floyd**
 RR#, St. Address, Box #: **1210 North Western Liberal, Kansas**
 City, State, ZIP Code: **Liberal, Kansas**
 Board of Agriculture, Division of Water Resources
 Application Number:

3 LOCATE WELL'S LOCATION WITH AN "X" IN SECTION BOX:

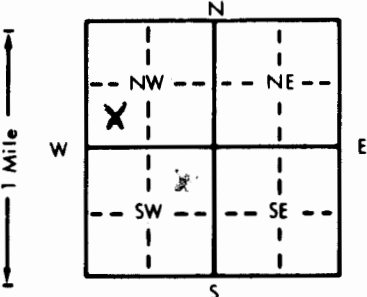

4 DEPTH OF COMPLETED WELL: **260** ft. ELEVATION: _____
 Depth(s) Groundwater Encountered 1. **115** ft. 2. _____ ft. 3. _____ ft.
 WELL'S STATIC WATER LEVEL: **145** ft. below land surface measured on **11/9/83**
 Pump test data: Well water was _____ ft. after _____ hours pumping _____ gpm
 Est. Yield **60** gpm: Well water was _____ ft. after _____ hours pumping _____ gpm
 Bore Hole Diameter: **9** in. to **260** ft. and _____ in. to _____ ft.
 WELL WATER TO BE USED AS:
 1 Domestic 3 Feedlot 6 Oil field water supply 9 Dewatering 12 Other (Specify below)
 2 Irrigation 4 Industrial 7 Lawn and garden only 10 Observation well
 Was a chemical/bacteriological sample submitted to Department? Yes _____ No No; If yes, mo/day/yr sample was submitted
 Water Well Disinfected? Yes _____ No _____

5 TYPE OF BLANK CASING USED:
 1 Steel 3 RMP (SR) 5 Wrought iron 8 Concrete tile CASING JOINTS: Glued _____ Clamped _____
 2 PVC 4 ABS 6 Asbestos-Cement 9 Other (specify below) Welded _____
 7 Fiberglass Threaded _____

Blank casing diameter: **5** in. to **220** ft. Dia. _____ in. to _____ ft. Dia. _____ in. to _____ ft.
 Casing height above land surface: **28** in., weight **2.78** lbs./ft. Wall thickness or gauge No. **256**

TYPE OF SCREEN OR PERFORATION MATERIAL:
 1 Steel 3 Stainless steel 5 Fiberglass 8 RMP (SR) 10 Asbestos-cement
 2 Brass 4 Galvanized steel 6 Concrete tile 9 ABS 11 Other (specify) _____
 12 None used (open hole)

SCREEN OR PERFORATION OPENINGS ARE:
 1 Continuous slot 3 Mill slot 5 Gauzed wrapped 8 Saw cut 11 None (open hole)
 2 Louvered shutter 4 Key punched 6 Wire wrapped 9 Drilled holes
 7 Torch cut 10 Other (specify) _____

SCREEN-PERFORATED INTERVALS: From **220** ft. to **260** ft., From _____ ft. to _____ ft.
 From _____ ft. to _____ ft., From _____ ft. to _____ ft.
 GRAVEL PACK INTERVALS: From **80** ft. to **260** ft., From _____ ft. to _____ ft.
 From _____ ft. to _____ ft., From _____ ft. to _____ ft.

6 GROUT MATERIAL: 1 Neat cement 2 Cement grout 3 Bentonite 4 Other _____
 Grout Intervals: From **0** ft. to **10** ft., From _____ ft. to _____ ft., From _____ ft. to _____ ft.

What is the nearest source of possible contamination: **None**
 1 Septic tank 4 Lateral lines 7 Pit privy 10 Livestock pens 14 Abandoned water well
 2 Sewer lines 5 Cess pool 8 Sewage lagoon 11 Fuel storage 15 Oil well/Gas well
 3 Watertight sewer lines 6 Seepage pit 9 Feedyard 12 Fertilizer storage 16 Other (specify below)
 13 Insecticide storage _____

Direction from well? _____ How many feet? _____

FROM	TO	LITHOLOGIC LOG	FROM	TO	LITHOLOGIC LOG
0	2	6/ surface			
2	36	19 clay & caliche			
36	80	0/ clay			
80	106	07 fine sand			
106	138	0/ clay			
138	260	05 fine sand & medium to large sand			

7 CONTRACTOR'S OR LANDOWNER'S CERTIFICATION: This water well was (1) constructed, (2) reconstructed, or (3) plugged under my jurisdiction and was completed on (mo/day/year) **November 9, 1983** and this record is true to the best of my knowledge and belief. Kansas Water Well Contractor's License No. **118**. This Water Well Record was completed on (mo/day/yr) **November 11, 1983** under the business name of **Carlile Water Well Service, Inc.** by (signature) *Edward S. Means*

INSTRUCTIONS: Use typewriter or ball point pen, PLEASE PRESS FIRMLY and PRINT clearly. Please fill in blanks, underline or circle the correct answers. Send top three copies to Kansas Department of Health and Environment, Division of Environment, Environmental Geology Section, Topeka, KS 66620. Send one to WATER WELL OWNER and retain one for your records.

OFFICE USE ONLY
T
31
R
29
EW
SEC
34
CSW
1/4
NW

DP