

WATER WELL RECORD

Form WWC-5

Division of Water Resources App. No.


1,447

1 LOCATION OF WATER WELL: County: MEADE	Fraction $\frac{1}{4}$ SW $\frac{1}{4}$ SW $\frac{1}{4}$ SE $\frac{1}{4}$	Section Number 13	Township No. T 31 S	Range Number R 29 <input type="checkbox"/> E <input checked="" type="checkbox"/> W
--	--	-----------------------------	-------------------------------	--

Street/Rural Address of Well Location; if unknown, distance & direction from nearest town or intersection: If at owner's address, check here .
FROM MISSLER - 1-1/2 MILES NORTH, 1 MILE EAST, 285 FT. NORTH & 2,450 FT. WEST

Global Positioning System (GPS) information:
 Latitude: (in decimal degrees)
 Longitude: (in decimal degrees)
 Elevation:
 Datum: WGS 84, NAD 83, NAD 27
 Collection Method:
 GPS unit (Make/Model:)
 Digital Map/Photo, Topographic Map, Land Survey
 Est. Accuracy: <3 m, 3-5 m, 5-15 m, >15 m

2 WATER WELL OWNER: **FRY FAMILY FARMS, C/O AG RR#, Street Address, Box #: MANAGEMENT, PO BOX 1013 City, State, ZIP Code : GARDEN CITY, KS 67846**

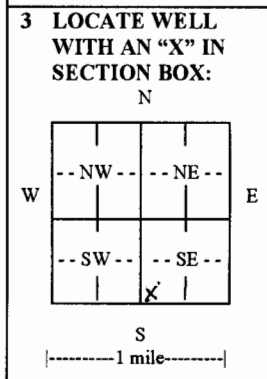

4 DEPTH OF COMPLETED WELL **425** ft.

Depth(s) Groundwater Encountered (1)..... ft. (2)..... ft. (3)..... ft.
 WELL'S STATIC WATER LEVEL **228** ft. below land surface measured on mo/day/yr. **3-18-10**
 Pump test data: Well water was.....ft. after..... hours pumping..... gpm
 EST. YIELD..... gpm. Well water was.....ft. after..... hours pumping..... gpm
 Bore Hole Diameter **30** in. to **425** ft., andin. toft.
 WELL WATER TO BE USED AS: Public water supply Geothermal Injection well
 Domestic Feedlot Oil field water supply Dewatering Other (Specify below)
 Irrigation Industrial Domestic-lawn & garden Monitoring well
 Was a chemical/bacteriological sample submitted to Department? Yes No
 If yes, mo/day/yr sample was submitted.....
 Water well disinfected? Yes No

5 TYPE OF CASING USED: Steel PVC Other

CASING JOINTS: Glued Clamped Welded Threaded
 Casing diameter **16** in. to **300** ft., Diameter in. to ft., Diameter in. to ft.
 Casing height above land surface **12** in., Weight **42.05** lbs./ft., Wall thickness or gauge No. **250**
 TYPE OF SCREEN OR PERFORATION MATERIAL:
 Steel Stainless Steel PVC Other (Specify)
 Brass Galvanized Steel None used (open hole)
 SCREEN OR PERFORATION OPENINGS ARE:
 Continuous slot Mill slot Gauze wrapped Torch cut Drilled holes None (open hole)
 Louvered shutter Key punched Wire wrapped Saw cut Other (specify)
 SCREEN-PERFORATED INTERVALS: From **300** ft. to **425** ft., From ft. to ft.
 From ft. to ft., From ft. to ft.
 GRAVEL PACK INTERVALS: From **20** ft. to **225** ft., From **285** ft. to **425** ft.
 From ft. to ft., From ft. to ft.

6 GROUT MATERIAL: Neat cement Cement grout Bentonite Other

Grout Intervals: From **0** ft. to **20** ft., From **225** ft. to **285** ft., From ft. to ft.
 What is the nearest source of possible contamination:
 Septic tank Lateral lines Pit privy Livestock pens Insecticide storage Other (specify below)
 Sewer lines Cesspool Sewage lagoon Fuel storage Abandoned water well
 Watertight sewer lines Seepage pit Feedyard Fertilizer storage Oil well/gas well
 Direction from well **SOUTHWEST** Distance from well **35' S. & 85' W.**

FROM	TO	LITHOLOGIC LOG	FROM	TO	LITHO. LOG (cont.) or PLUGGING INTERVALS
		SEE ATTACHED LOG			

7 CONTRACTOR'S OR LANDOWNER'S CERTIFICATION: This water well was constructed, reconstructed, or plugged under my jurisdiction and was completed on (mo/day/year) **3-18-10** and this record is true to the best of my knowledge and belief.
 Kansas Water Well Contractor's License No. **208** This Water Well Record was completed on (mo/day/year) **3-22-10**
 under the business name of **MINTER-WILSON DRLG. CO., INC.** by (signature) *Nora Keller*

INSTRUCTIONS: Use typewriter or ball point pen. **PLEASE PRESS FIRMLY** and **PRINT** clearly. Please fill in blanks and check the correct answers. Send three copies (white, blue, pink) to Kansas Department of Health and Environment, Bureau of Water, Geology Section, 1000 SW Jackson St., Suite 420, Topeka, Kansas 66612-1367. Telephone 785-296-5522. Send one copy to WATER WELL OWNER and retain one for your records. Include fee of \$5.00 for each constructed well. Visit us at <http://www.kdheks.gov/waterwell/index.html>.

*The
Professionals*

MINTER-WILSON DRILLING CO.

INCORPORATED

Irrigation
and Domestic
Water Systems
Complete Installation
and Repairing

Phone 620-276-8269 • P.O. Box A • GARDEN CITY, KANSAS 67846

NAME FRY FAMILY FARMS
COUNTY MEADE
DATE 1-11-10

LOCATION: SE 1/4 13-31-29 - SOUTH OF COPELAND TO J ROAD,
9-1/2 MILES EAST & 1/8TH MILE NORTH
- 100 FT. EAST OF EXISTING WELL

STATIC WATER LEVEL -

TEST #1

0' TO 2' - TOP SOIL
2' TO 54' - BROWN CLAY
54' TO 65' - BROWN SANDY CLAY
65' TO 75' - FINE TO MEDIUM SAND & GRAVEL
75' TO 84' - BROWN CLAY
84' TO 140' - FINE TO MEDIUM SAND & GRAVEL
140' TO 155' - BROWN CLAY
155' TO 255' - FINE TO MEDIUM SAND & GRAVEL
255' TO 264' - BROWN CLAY
264' TO 286' - BLUE CLAY - SMALL GRAVEL STREAKS
286' TO 291' - BROWN CLAY
291' TO 366' - FINE TO MEDIUM SAND & GRAVEL
366' TO 383' - FINE TO MEDIUM SAND & GRAVEL WITH CLAY STRIPS
383' TO 410' - FINE TO MEDIUM SAND & GRAVEL
410' TO 430' - BROWN CLAY
430' TO 485' - BROWN SANDY CLAY
485' TO 491' - BROWN CLAY
491' TO 496' - BROWN YELLOW CLAY - SMALL BROWN ROCK STREAK
496' TO 513' - YELLOW CLAY
513' TO 515' - GRAY SHALE