


1 LOCATION OF WATER WELL:	Fraction	Section Number	Township Number	Range Number
County: <u>Sumner</u>	<u>NW 1/4 SW 1/4 SW 1/4</u>	<u>10</u>	T <u>31</u> S	R <u>3</u> <u>W</u>

Distance and direction from nearest town or city street address of well if located within city?

23, Conway Springs

2 WATER WELL OWNER:	Board of Agriculture, Division of Water Resources
RR#, St. Address, Box #:	Application Number:
City, State, ZIP Code:	

3 LOCATE WELL'S LOCATION WITH AN "X" IN SECTION BOX:	4 DEPTH OF COMPLETED WELL:	74 ft. ELEVATION:
--	----------------------------	-------------------

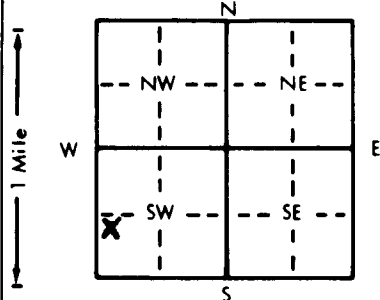

Depth(s) Groundwater Encountered	1. <u>25</u> ft.	2. <u>50</u> ft.	3. <u>66</u> ft.
WELL'S STATIC WATER LEVEL	<u>24</u> ft. below land surface measured on mo/day/yr	<u>7-7-95</u>	
Pump test data:	Well water was	ft. after	hours pumping
Est. Yield	gpm: Well water was	ft. after	hours pumping
Bore Hole Diameter	<u>5</u> in. to	<u>74</u> ft. and	in. to
WELL WATER TO BE USED AS:	5 Public water supply	8 Air conditioning	11 Injection well
1 Domestic	3 Feedlot	6 Oil field water supply	9 Dewatering
2 Irrigation	4 Industrial	7 Lawn and garden only	10 Monitoring well
Was a chemical/bacteriological sample submitted to Department? Yes ☒ No ☒ If yes, mo/day/yr sample was submitted			
Water Well Disinfected? Yes ☒ No ☒			

5 TYPE OF BLANK CASING USED:	5 Wrought iron	8 Concrete tile	CASING JOINTS: <u>Glued</u>	Clamped
1 Steel	3 RMP (SR)	6 Asbestos-Cement	9 Other (specify below)	Welded
2 <u>PVC</u>	4 ABS	7 Fiberglass		Threaded
Blank casing diameter	<u>5</u> in. to	<u>44</u> in. Dia	in. to	ft.
Casing height above land surface	<u>18</u> in. weight	lbs./ft. Wall thickness or gauge No.	<u>SDR26</u>	

TYPE OF SCREEN OR PERFORATION MATERIAL:	7 PVC	10 Asbestos-cement
1 Steel	8 RMP (SR)	11 Other (specify)
2 Brass	9 ABS	12 None used (open hole)
3 Stainless steel		
4 Galvanized steel		
5 Fiberglass		
6 Concrete tile		

SCREEN OR PERFORATION OPENINGS ARE:	5 Gauzed wrapped	8 Saw cut	11 None (open hole)
1 Continuous slot	6 Wire wrapped	9 Drilled holes	
2 Louvered shutter	7 Torch cut	10 Other (specify)	
4 Key punched			



What is the nearest source of possible contamination:	10 Livestock pens	14 Abandoned water well
1 Septic tank	11 Fuel storage	15 Oil well/Gas well
2 Sewer lines	12 Fertilizer storage	16 Other (specify below)
3 Watertight sewer lines	13 Insecticide storage	
4 Lateral lines		
5 Cess pool		
6 Seepage pit		
7 Pit privy		
8 <u>Sewage lagoon</u>		
9 Feedyard		

Direction from well?	<u>NE</u>	How many feet?	<u>300</u>
----------------------	-----------	----------------	------------

FROM	TO	LITHOLOGIC LOG	FROM	TO	PLUGGING INTERVALS
<u>0</u>	<u>1</u>	<u>Soil</u>			
<u>1</u>	<u>8</u>	<u>Clay</u>			
<u>8</u>	<u>74</u>	<u>Red Shale</u>			

7 CONTRACTOR'S OR LANDOWNER'S CERTIFICATION: This water well was (1) <u>constructed</u> , (2) reconstructed, or (3) plugged under my jurisdiction and was completed on (mo/day/year) <u>7-24-95</u> and this record is true to the best of my knowledge and belief. Kansas Water Well Contractor's License No. <u>395</u> This Water Well Record was completed on (mo/day/yr) <u>7-24-95</u> under the business name of <u>Craig Roberts Co.</u> by (signature) <u>Craig Roberts</u>
--