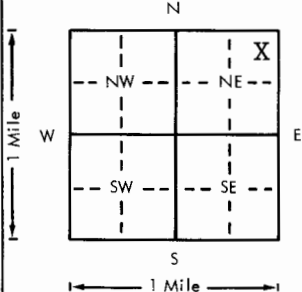


USE TYPEWRITER OR BALL
POINT PEN-PRESS FIRMLY,
PRINT CLEARLY.

WATER WELL RECORD
KSA 82a-1201-1215

Kansas Department of Health and
Environment-Division of Environment
(Water well Contractors)
Topeka, Kansas 66620

1. Location of well:		County SUMNER	Fraction 1/4 NE 1/4 NE 1/4	Section number 5	Township number T 31 S	Range number R 3W E/W
2. Distance and direction from nearest town or city: (1 1/8)		3. Owner of well: Francis McClain Box 519 R.R. #2 Conway Springs, Kansas				
4. Locate with "X" in section below: 		Sketch map: of the road. Conway Springs, Kansas		6. Bore hole dia. 11 in. Completion date 4-3-78 Well depth 50 ft.		
5. Type and color of material		From		To		7. <input checked="" type="checkbox"/> Cable tool <input checked="" type="checkbox"/> Rotary <input type="checkbox"/> Driven <input type="checkbox"/> Dug <input type="checkbox"/> Hollow rod <input type="checkbox"/> Jetted <input type="checkbox"/> Bored <input type="checkbox"/> Reverse rotary
Topsoil		0		3		8. Use: <input type="checkbox"/> Domestic <input type="checkbox"/> Public supply <input type="checkbox"/> Industry <input type="checkbox"/> Irrigation <input type="checkbox"/> Air conditioning <input type="checkbox"/> Stock <input checked="" type="checkbox"/> Lawn <input type="checkbox"/> Oil field water <input type="checkbox"/> Other
Fine Sand		3		13		9. Casing: Material styrene Height: Above or below Threaded <input type="checkbox"/> Welded <input checked="" type="checkbox"/> Surface 12 in. RMP <input checked="" type="checkbox"/> PVC <input type="checkbox"/> Weight 12 lbs./ft. Dia. 5 in. to 50 ft. depth Wall Thickness: inches or Dia. 5 in. to 50 ft. depth gage No. .200
Red Shale		13		50		10. Screen: Manufacturer's name Sunflower Plastic Type styrene Dia. 5" Slot 1/16" Length 35' Set between 15 ft. and 50 ft. Gravel pack? yes Size range of material 1/4-1/8"
						11. Static water level: 15 ft. below land surface Date 4-3-78
						12. Pumping level below land surfaces: ____ ft. after ____ hrs. pumping ____ g.p.m. ____ ft. after ____ hrs. pumping ____ g.p.m. Estimated maximum yield ____ g.p.m.
						13. Water sample submitted: ____ mo./day/yr. ____ Yes ____ No Date ____
						14. Well head completion: capped ____ Pitless adapter 12 Inches above grade
						15. Well grouted? yes 1-2 Fine Sand Mix With: ____ Neat cement ____ Bentonite <input checked="" type="checkbox"/> Concrete Depth: From 40" ft. to 14 ft.
						16. Nearest source of possible contamination: septic ft. 200 Direction N.E. Type tank Well disinfected upon completion? <input checked="" type="checkbox"/> Yes ____ No
						17. Pump: <input checked="" type="checkbox"/> Not installed Manufacturer's name ____ Model number ____ HP ____ Volts ____ Length of drop pipe ____ ft. capacity ____ g.p.m. Type: ____ Submersible ____ Turbine ____ Jet ____ Reciprocating ____ Centrifugal ____ Other
						(Use a second sheet if needed)
18. Elevation:	19. Remarks: Flat Ground Pump not installed at this time.		20. Water well contractor's certification: This well was drilled under my jurisdiction and this report is true to the best of my knowledge and belief. Harp Well & Pump 236 Business name License No. Address Wichita, Kansas 67209 Signed M. Arnold Date 6-9-78 Authorized representative			
Topography: ____ Hill ____ Slope ____ Upland ____ Valley						

Forward the white, blue and pink copies to the Department of Health and Environment

Form WWC-5