


1 LOCATION OF WATER WELL: County: Meade Fraction NE 1/4 NE 1/4 SE 1/4 Section Number 17 Township Number T 31 S Range Number R 30 EW

Distance and direction from nearest town or city street address of well if located within city? 5 1/4 Miles North of Plains, Kansas

2 WATER WELL OWNER: John Amerin Jr. RR#, St. Address, Box #: R.F.D. Board of Agriculture, Division of Water Resources City, State, ZIP Code: Plains, Kansas 67869 Application Number:

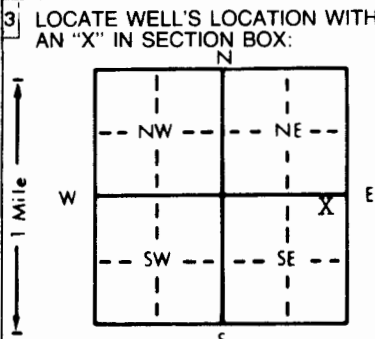

4 DEPTH OF COMPLETED WELL: 280' ft. ELEVATION: WELL'S STATIC WATER LEVEL: 240 ft. below land surface measured on mo/day/yr

Depth(s) Groundwater Encountered 1. ft. 2. ft. 3. ft.

Pump test data: Well water was ft. after hours pumping gpm

Est. Yield gpm: Well water was ft. after hours pumping gpm

Bore Hole Diameter in. to ft. and in. to ft.

WELL WATER TO BE USED AS:

|                       |                    |                          |
|-----------------------|--------------------|--------------------------|
| 5 Public water supply | 8 Air conditioning | 11 Injection well        |
| 1 Domestic            | 3 Feedlot          | 6 Oil field water supply |
| 2 Irrigation          | 4 Industrial       | 7 Lawn and garden only   |
|                       |                    | 10 Monitoring well       |
|                       |                    | 9 Dewatering             |
|                       |                    | 12 Other (Specify below) |

Was a chemical/bacteriological sample submitted to Department? Yes No  If yes, mo/day/yr sample was submitted

Water Well Disinfected? Yes  No

5 TYPE OF BLANK CASING USED:

|   |            |                   |                         |                              |
|---|------------|-------------------|-------------------------|------------------------------|
| <input checked="" type="checkbox"/> Steel | 3 RMP (SR) | 5 Wrought iron    | 8 Concrete tile         | CASING JOINTS: Glued Clamped |
| 2 PVC                                     | 4 ABS      | 6 Asbestos-Cement | 9 Other (specify below) | Welded                       |
|   |            | 7 Fiberglass      |                         | Threaded                     |

Blank casing diameter 5 in. to ft., Dia in. to ft., Dia in. to ft.

Casing height above land surface 60 in., weight lbs./ft. Wall thickness or gauge No.

TYPE OF SCREEN OR PERFORATION MATERIAL:

|         |                    |                 |            |                          |
|---------|--------------------|-----------------|------------|--------------------------|
| 1 Steel | 3 Stainless steel  | 5 Fiberglass    | 8 RMP (SR) | 11 Other (specify) N/A   |
| 2 Brass | 4 Galvanized steel | 6 Concrete tile | 9 ABS      | 12 None used (open hole) |

SCREEN OR PERFORATION OPENINGS ARE:

|                    |               |                  |                        |                     |
|--------------------|---------------|------------------|------------------------|---------------------|
| 1 Continuous slot  | 3 Mill slot   | 5 Gauzed wrapped | 8 Saw cut              | 11 None (open hole) |
| 2 Louvered shutter | 4 Key punched | 6 Wire wrapped   | 9 Drilled holes        |                     |
|                    |               | 7 Torch cut      | 10 Other (specify) N/A |                     |

SCREEN-PERFORATED INTERVALS: From N/A ft. to N/A ft., From ft. to ft., From ft. to ft., From ft. to ft.

GRAVEL PACK INTERVALS: From ft. to ft., From ft. to ft., From ft. to ft., From ft. to ft.

6 GROUT MATERIAL: 1 Neat cement 2 Cement grout 3 Bentonite 4 Other

Grout Intervals: From 20 ft. to 5 ft., From ft. to ft., From ft. to ft., From ft. to ft.

What is the nearest source of possible contamination:

|                          |                 |                 |                        |                               |
|--------------------------|-----------------|-----------------|------------------------|-------------------------------|
| 1 Septic tank            | 4 Lateral lines | 7 Pit privy     | 10 Livestock pens      | 14 Abandoned water well       |
| 2 Sewer lines            | 5 Cess pool     | 8 Sewage lagoon | 11 Fuel storage        | 15 Oil well/Gas well          |
| 3 Watertight sewer lines | 6 Seepage pit   | 9 Feedyard      | 12 Fertilizer storage  | 16 Other (specify below) NONE |
|                          |                 |                 | 13 Insecticide storage |                               |

Direction from well? How many feet?

| FROM | TO | LITHOLOGIC LOG | FROM    | TO  | PLUGGING INTERVALS |
|------|----|----------------|---------|-----|--------------------|
|      |    |                | 5       | 20  | Bentonite Chips    |
|      |    |                | 20      | 240 | Fill Dirt          |
|      |    |                | 240-280 |     | Gravel             |

7 CONTRACTOR'S OR LANDOWNER'S CERTIFICATION: This water well was (1) constructed, (2) reconstructed, or (3) plugged under my jurisdiction and was completed on (mo/day/year) Feb. 11, 1992 and this record is true to the best of my knowledge and belief. Kansas Water Well Contractor's License No. 252 This Water Well Record was completed on (mo/day/year) Feb. 14, 1992 under the business name of Friesen Windmill & Supply Inc. by (signature)

OFFICE USE ONLY

T

R

EW

SEC.

1/4

1/4

1/4