


1 LOCATION OF WATER WELL:	Fraction NE ¼ NE ¼ SE ¼	Section Number 17	Township Number T 31 S	Range Number R 30 E/W
----------------------------------	----------------------------	----------------------	---------------------------	--------------------------

Distance and direction from nearest town or city street address of well if located within city?
 5 1/4 Miles North of Plains, Kansas

2 WATER WELL OWNER:	John Amerin Jr. R.F.D. Plains, Kansas 67869	Board of Agriculture, Division of Water Resources Application Number: ---
----------------------------	---	--

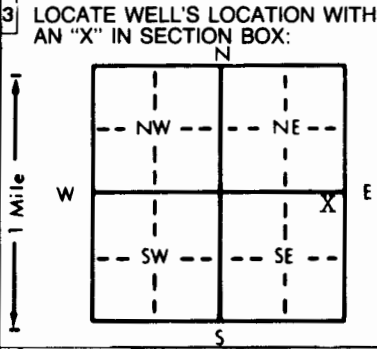

4 DEPTH OF COMPLETED WELL: 460 ft.	ELEVATION: .. Slope ..	
Depth(s) Groundwater Encountered 1. Not available ft. 2. ft. 3. ft.		
WELL'S STATIC WATER LEVEL ... 241 ... ft. below land surface measured on mo/day/yr Feb. 7, 1992		
Pump test data: Well water was ft. after hours pumping gpm		
Est. Yield 20 ... gpm: Well water was ft. after hours pumping gpm		
Bore Hole Diameter ... 10 ... in. to ... 460 ... ft., and ... in. to ... ft.		
WELL WATER TO BE USED AS:		
5 Public water supply	8 Air conditioning	11 Injection well
XX Domestic	3 Feedlot	6 Oil field water supply
9 Dewatering	12 Other (Specify below)	
2 Irrigation	4 Industrial	7 Lawn and garden only
	10 Monitoring well	
Was a chemical/bacteriological sample submitted to Department? Yes.....No..XX.....; If yes, mo/day/yr sample was submitted		
Water Well Disinfected? Yes XX No		

5 TYPE OF BLANK CASING USED:	5 Wrought iron	8 Concrete tile	CASING JOINTS: Glued .XX.. Clamped
1 Steel	3 RMP (SR)	6 Asbestos-Cement	9 Other (specify below)
XX PVC	4 ABS	7 Fiberglass
Blank casing diameter ... 5 ... in. to ... 400 ... ft., Dia ... in. to ... ft., Dia ... in. to ... ft.			
Casing height above land surface ... 18 ... in., weight ... 2.8 ... lbs./ft. Wall thickness or gauge No. ... 265			
TYPE OF SCREEN OR PERFORATION MATERIAL:			
1 Steel	3 Stainless steel	5 Fiberglass	8 RMP (SR)
2 Brass	4 Galvanized steel	6 Concrete tile	9 ABS
			10 Asbestos-cement
			11 Other (specify)
			12 None used (open hole)
SCREEN OR PERFORATION OPENINGS ARE:			
1 Continuous slot	XX Mill slot	5 Gauzed wrapped	8 Saw cut
2 Louvered shutter	4 Key punched	6 Wire wrapped	9 Drilled holes
		7 Torch cut	10 Other (specify)
SCREEN-PERFORATED INTERVALS:			
From ... 400 ... ft. to ... 460 ... ft.,		From ... ft. to ... ft.	
From ... ft. to ... ft.,		From ... ft. to ... ft.	
GRAVEL PACK INTERVALS:			
From ... 20 ... ft. to ... 460 ... ft.,		From ... ft. to ... ft.	
From ... ft. to ... ft.,		From ... ft. to ... ft.	

6 GROUT MATERIAL:	1 Neat cement	2 Cement grout	XX Bentonite	4 Other
Grout Intervals: From ... 0 ... ft. to ... 20 ... ft., From ... ft. to ... ft., From ... ft. to ... ft.				
What is the nearest source of possible contamination:				
XX Septic tank	4 Lateral lines	7 Pit privy	10 Livestock pens	14 Abandoned water well
2 Sewer lines	5 Cess pool	8 Sewage lagoon	11 Fuel storage	15 Oil well/Gas well
3 Watertight sewer lines	6 Seepage pit	9 Feedyard	12 Fertilizer storage	16 Other (specify below)
			13 Insecticide storage
Direction from well? South			How many feet? 100	

FROM	TO	LITHOLOGIC LOG	FROM	TO	PLUGGING INTERVALS
0	2	Topsoil			
2	71	Clay			
71	147	Med. Sand			
147	297	Blue Clay			
297	451	Med. Sand & Gravel			
451	460	Blue Clay			

7 CONTRACTOR'S OR LANDOWNER'S CERTIFICATION: This water well was (1) <u>constructed</u> , (2) reconstructed, or (3) plugged under my jurisdiction and was completed on (mo/day/year) .. February 11, 1992 .. and this record is true to the best of my knowledge and belief. Kansas Water Well Contractor's License No. ... 252 .. This Water Well Record was completed on (mo/day/yr) .. Feb. 12, 1992 .. under the business name of <u>Friesen Windmill & Supply Inc.</u> by (signature)	
---	--

INSTRUCTIONS: Use typewriter or ball point pen. PLEASE PRESS FIRMLY and PRINT clearly. Please fill in blanks, underline or circle the correct answers. Send top three copies to Kansas Department of Health and Environment, Bureau of Water, Topeka, Kansas 66620-0001. Telephone: 913-296-5545. Send one to WATER WELL OWNER and retain one for your records.

LL1ZE1SONE