


1 LOCATION OF WATER WELL: County: **MEADE** Fraction **NE 1/4 NE 1/4 SE 1/4** Section Number **19** Township Number **T 31 S** Range Number **R 30 EW**

Distance and direction from nearest town or city street address of well if located within city?
4 North, 1 West, 1/2 North of Plains, Kansas

2 WATER WELL OWNER: **George Eakes**
 RR#, St. Address, Box # : **Plains, Kansas 67869** Board of Agriculture, Division of Water Resources
 City, State, ZIP Code : **Plains, Kansas 67869** Application Number: **---**

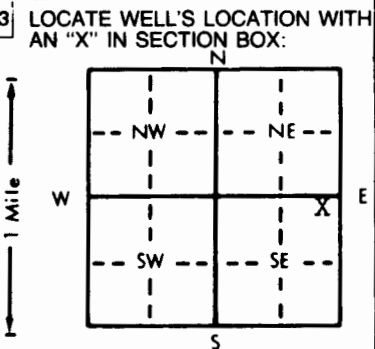

4 DEPTH OF COMPLETED WELL: **400** ft. ELEVATION: **Slope**
 WELL'S STATIC WATER LEVEL **192** ft. below land surface measured on **mo/day/yr Nov. 12, 1991**
 Est. Yield **20** gpm: Well water was **Not available** ft. after **Not available** hours pumping **Not available** gpm
 Bore Hole Diameter **10** in. to **400** ft. and **Not available** in. to **Not available** ft.
 WELL WATER TO BE USED AS: 5 Public water supply 8 Air conditioning 11 Injection well
 Domestic 3 Feedlot 6 Oil field water supply 9 Dewatering 12 Other (Specify below)
 2 Irrigation 4 Industrial 7 Lawn and garden only 10 Monitoring well
 Was a chemical/bacteriological sample submitted to Department? Yes **Not available** No ; If yes, mo/day/yr sample was submitted
 Water Well Disinfected? Yes No

5 TYPE OF BLANK CASING USED: 5 Wrought iron 8 Concrete tile CASING JOINTS: Glued Clamped
 1 Steel 3 RMP (SR) 6 Asbestos-Cement 9 Other (specify below) Welded
 PVC 4 ABS 7 Fiberglass Threaded
 Blank casing diameter **5** in. to **360** ft., Dia **Not available** in. to **Not available** ft., Dia **Not available** in. to **Not available** ft.
 Casing height above land surface **18** in., weight **2.8** lbs./ft. Wall thickness or gauge No. **265**
 TYPE OF SCREEN OR PERFORATION MATERIAL: PVC 10 Asbestos-cement
 1 Steel 3 Stainless steel 5 Fiberglass 8 RMP (SR) 11 Other (specify)
 2 Brass 4 Galvanized steel 6 Concrete tile 9 ABS 12 None used (open hole)
 SCREEN OR PERFORATION OPENINGS ARE: 5 Gauzed wrapped Saw cut 11 None (open hole)
 1 Continuous slot 3 Mill slot 6 Wire wrapped 9 Drilled holes
 2 Louvered shutter 4 Key punched 7 Torch cut 10 Other (specify)
 SCREEN-PERFORATED INTERVALS: From **360** ft. to **400** ft., From **Not available** ft. to **Not available** ft.
 GRAVEL PACK INTERVALS: From **25** ft. to **400** ft., From **Not available** ft. to **Not available** ft.

6 GROUT MATERIAL: 1 Neat cement 2 Cement grout Bentonite 4 Other
 Grout Intervals: From **5** ft. to **25** ft., From **Not available** ft. to **Not available** ft., From **Not available** ft. to **Not available** ft.
 What is the nearest source of possible contamination:
 Septic tank 4 Lateral lines 7 Pit privy 10 Livestock pens 14 Abandoned water well
 2 Sewer lines 5 Cess pool 8 Sewage lagoon 11 Fuel storage 15 Oil well/Gas well
 3 Watertight sewer lines 6 Seepage pit 9 Feedyard 12 Fertilizer storage 16 Other (specify below)
 13 Insecticide storage
 Direction from well? **South** How many feet? **100**

FROM	TO	LITHOLOGIC LOG	FROM	TO	PLUGGING INTERVALS
0	2	Topsoil			
2	56	Clay			
56	64	Caliche			
64	120	Med. Sand			
120	260	Blue Clay and Strippy Sand			
260	304	Med. Sand			
304	348	Blue Clay			
348	400	Large Sand			

7 CONTRACTOR'S OR LANDOWNER'S CERTIFICATION: This water well was (1) constructed, (2) reconstructed, or (3) plugged under my jurisdiction and was completed on (mo/day/year) **November 13, 1991** and this record is true to the best of my knowledge and belief. Kansas Water Well Contractor's License No. **252** This Water Well Record was completed on (mo/day/year) **November 15, 1991** under the business name of **Friesen Windmill & Supply Inc.** by (signature) *[Signature]*

INSTRUCTIONS: Use typewriter or ball point pen. PLEASE PRESS FIRMLY and PRINT clearly. Please fill in blanks, underline or circle the correct answers. Send top three copies to Kansas Department of Health and Environment, Bureau of Water, Topeka, Kansas 66620-0001. Telephone: 913-296-5545. Send one to WATER WELL OWNER and retain one for your records.

3105132175

OFFICE USE ONLY
T
R
EW
SEC.
1/4
1/4
1/4