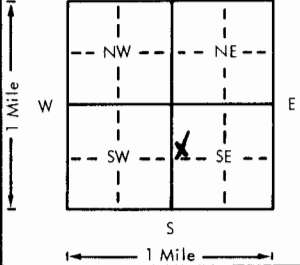


USE TYPEWRITER OR BALL POINT PEN-PRESS FIRMLY, PRINT CLEARLY.

WATER WELL RECORD
KSA 82a-1201-1215

Kansas Department of Health and Environment-Division of Environment (Water well Contractors) Topeka, Kansas 66620

1. Location of well:	County Meade	Fraction SW 1/4 ^W NE 1/4 SE 1/4	Section number 23	Township number T 31 S R 30	Range number EW
2. Distance and direction from nearest town or city: Approximately 6 1/4 Miles NW of Missler, Kansas. Street address of well location if in city:			3. Owner of well: Edna Collingwood Trust R.R. or street: C/O Keith Zody, Box 1184 City, state, zip code: Hutchinson, Kansas 67501		
4. Locate with "X" in section below: N W E S 1 Mile 1 Mile			Sketch map: 		
5. Type and color of material			From	To	6. Bore hole dia. <u>16</u> in. Completion date <u>8/14/78</u> Well depth <u>448</u> ft.
See Attachment			7. <input type="checkbox"/> Cable tool <input type="checkbox"/> Rotary <input type="checkbox"/> Driven <input type="checkbox"/> Dug <input type="checkbox"/> Hollow rod <input type="checkbox"/> Jetted <input type="checkbox"/> Bored <input checked="" type="checkbox"/> Reverse rotary		
			8. Use: <input type="checkbox"/> Domestic <input type="checkbox"/> Public supply <input type="checkbox"/> Industry <input checked="" type="checkbox"/> Irrigation <input type="checkbox"/> Air conditioning <input type="checkbox"/> Stock <input type="checkbox"/> Lawn <input type="checkbox"/> Oil field water <input type="checkbox"/> Other		
			9. Casing: Material <u>Steel</u> Height: <u>Above</u> or below Threaded <input type="checkbox"/> Welded <input checked="" type="checkbox"/> Surface <u>12</u> in. RMP <input type="checkbox"/> PVC <input type="checkbox"/> Weight <u>36.91</u> lbs./ft. Dia. <u>16</u> in. to <u>448</u> ft. depth Wall Thickness: inches or Dia. <input type="checkbox"/> in. to <input type="checkbox"/> ft. depth Gauge No. <u>.219</u>		
			10. Screen: Manufacturer's name <u>W. A. Brown</u> Type <u>Louvered</u> Dia. <u>16"</u> Slot/gauze <u>.125</u> Length <u>100'</u> Set between <u>225</u> ft. and <u>285</u> ft. <u>305-325</u> ft. and <u>425-445</u> ft. Gravel pack? <input checked="" type="checkbox"/> Yes Size range of material <u>#1 Coarse</u>		
			11. Static water level: <u>179</u> ft. below land surface Date <u>8/16/78</u> mo./day/yr.		
			12. Pumping level below land surfaces: <u>241</u> ft. after <input type="checkbox"/> hrs. pumping <u>1,404</u> g.p.m. <input type="checkbox"/> ft. after <input type="checkbox"/> hrs. pumping <input type="checkbox"/> g.p.m. Estimated maximum yield <u>1,400</u> g.p.m.		
			13. Water sample submitted: <input checked="" type="checkbox"/> Yes <input type="checkbox"/> No Date <input type="checkbox"/>		
			14. Well head completion: <input type="checkbox"/> Pitless adapter <u>12</u> Inches above grade		
			15. Well grouted? <input checked="" type="checkbox"/> Yes With: <input type="checkbox"/> Neat cement <input checked="" type="checkbox"/> Bentonite <input type="checkbox"/> Concrete Depth: From <u>0</u> ft. to <u>10</u> ft.		
			16. Nearest source of possible contamination: <u>None</u> ft. <input type="checkbox"/> Direction <input type="checkbox"/> Type <u>Observed</u> Well disinfected upon completion? <input type="checkbox"/> Yes <input checked="" type="checkbox"/> No		
			17. Pump: <input checked="" type="checkbox"/> Not installed Manufacturer's name <input type="checkbox"/> Model number <input type="checkbox"/> HP <input type="checkbox"/> Volts <input type="checkbox"/> Length of drop pipe <input type="checkbox"/> ft. capacity <input type="checkbox"/> g.p.m. Type: <input type="checkbox"/> Submersible <input type="checkbox"/> Turbine <input type="checkbox"/> Jet <input type="checkbox"/> Reciprocating <input type="checkbox"/> Centrifugal <input type="checkbox"/> Other		
			(Use a second sheet if needed)		
18. Elevation: <u>x Flat</u> Topography: <input type="checkbox"/> Hill <input type="checkbox"/> Slope <input type="checkbox"/> Upland <input type="checkbox"/> Valley	19. Remarks:		20. Water well contractor's certification: This well was drilled under my jurisdiction and this report is true to the best of my knowledge and belief. Henkle Drilling & Sply 145 Business name License No. <input type="checkbox"/> Address Box 639 Garden City, Ks Signed <u>Erica Bethune</u> Date <u>8/17/78</u> Authorized representative		

Forward the white, blue and pink copies to the Department of Health and Environment

Form WWC-5

