


1 LOCATION OF WATER WELL: Fraction NE 1/4 NE 1/4 SW 1/4 Section Number 27 Township Number T 31 S Range Number R 30 EW
 County: MEADE

Distance and direction from nearest town or city street address of well if located within city?
 3 North, 1/2 East, 1/2 North of Plains, Kansas

2 WATER WELL OWNER: Vicki Lee
 RR#, St. Address, Box #: Rt. #1 Board of Agriculture, Division of Water Resources
 City, State, ZIP Code: Plains, Kansas 67869 Application Number: ---

3 LOCATE WELL'S LOCATION WITH AN "X" IN SECTION BOX:

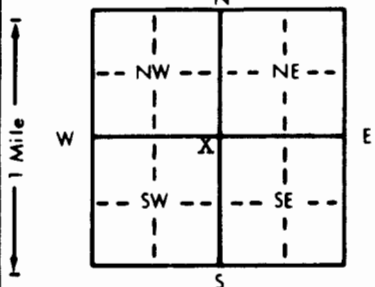

4 DEPTH OF COMPLETED WELL: 290 ft. ELEVATION: Slope
 Depth(s) Groundwater Encountered: 1. Not available ft. 2. ft. 3. ft.
 WELL'S STATIC WATER LEVEL: 203 ft. below land surface measured on mo/day/yr August 30, 1991
 Pump test data: Well water was ft. after hours pumping gpm
 Est. Yield: 20 gpm; Well water was ft. after hours pumping gpm
 Bore Hole Diameter: 10 in. to ft., and in. to ft.
 WELL WATER TO BE USED AS:
 Domestic 3 Feedlot 6 Oil field water supply 9 Dewatering 12 Other (Specify below)
 2 Irrigation 4 Industrial 7 Lawn and garden only 10 Monitoring well
 Was a chemical/bacteriological sample submitted to Department? Yes No If yes, mo/day/yr sample was submitted
 Water Well Disinfected? Yes No

5 TYPE OF BLANK CASING USED:
 Steel 3 RMP (SR) 6 Asbestos-Cement 9 Other (specify below) Welded
 PVC 4 ABS 7 Fiberglass Threaded
 Blank casing diameter: 5 in. to 250 ft. Dia. in. to ft. Dia. in. to ft.
 Casing height above land surface: 18 in. weight: 2.8 lbs./ft. Wall thickness or gauge No. .265
 TYPE OF SCREEN OR PERFORATION MATERIAL:
 Steel 3 Stainless steel 5 Fiberglass 8 RMP (SR) 10 Asbestos-cement
 2 Brass 4 Galvanized steel 6 Concrete tile 9 ABS 11 Other (specify)
 12 None used (open hole)
 SCREEN OR PERFORATION OPENINGS ARE:
 1 Continuous slot 3 Mill slot 5 Gauzed wrapped 8 Saw cut 11 None (open hole)
 2 Louvered shutter 4 Key punched 6 Wire wrapped 9 Drilled holes
 7 Torch cut 10 Other (specify)
 SCREEN-PERFORATED INTERVALS: From 250 ft. to 290 ft. From ft. to ft.
 GRAVEL PACK INTERVALS: From 23 ft. to 290 ft. From ft. to ft.

6 GROUT MATERIAL: 1 Neat cement 2 Cement grout Bentonite 4 Other
 Grout Intervals: From 3 ft. to 23 ft. From ft. to ft. From ft. to ft.
 What is the nearest source of possible contamination:
 Septic tank 4 Lateral lines 7 Pit privy 10 Livestock pens 14 Abandoned water well
 2 Sewer lines 5 Cess pool 8 Sewage lagoon 11 Fuel storage 15 Oil well/Gas well
 3 Watertight sewer lines 6 Seepage pit 9 Feedyard 12 Fertilizer storage 16 Other (specify below)
 13 Insecticide storage
 Direction from well? West How many feet? 100

FROM	TO	LITHOLOGIC LOG	FROM	TO	PLUGGING INTERVALS
0	3	Topsoil			
3	131	Clay			
131	149	Large Sand			
149	203	Blue Clay			
203	251	Med. Sand			
251	263	Boulders			
263	290	Med. Sand			
290	320	Blue Clay			

7 CONTRACTOR'S OR LANDOWNER'S CERTIFICATION: This water well was (1) constructed, (2) reconstructed, or (3) plugged under my jurisdiction and was completed on (mo/day/year) August 30, 1991 and this record is true to the best of my knowledge and belief. Kansas Water Well Contractor's License No. 252 This Water Well Record was completed on (mo/day/year) September 3, 1991 under the business name of Friesen Windmill & Supply Inc. by (signature)

INSTRUCTIONS: Use typewriter or ball point pen. PLEASE PRESS FIRMLY and PRINT clearly. Please fill in blanks, underline or circle the correct answers. Send top three copies to Kansas Department of Health and Environment, Bureau of Water, Topeka, Kansas 66620-7320. Telephone: 913-296-5545. Send one to WATER WELL OWNER and retain one for your records.

6620921260299

OFFICE USE ONLY
T
R
EW
SEC.