USE TYPEWRITER OR BALL POINT PEN-PRESS FIRMLY, PRINT CLEARLY.

WATER WELL RECORD
KSA 82a-1201-1215

Kansas Department of Health and Environment-Division of Environment
(Water well Contractors)
Topeka, Kansas 66620

1. Location of well:	County	Fraction	Section number	Township number	Range number
	Meade	SE 1/4 SW 1/4 SW 1/4	28	T 31 S	R 30 E/W

2. Distance and direction from nearest town or city: 3 mi. N of
Street address of well location if in city: Plains, Kansas

3. Owner of well: Elvin Harris
R.R. or street: R. R.
City, state, zip code: Plains, Kansas

4. Locate with "X" in section below:

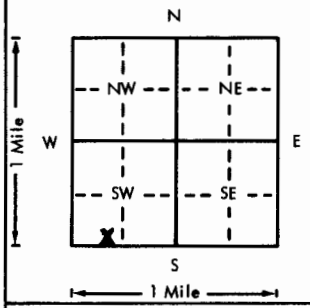

Sketch map:

1320' W of SE corner of SW¼, Sec. 28, T31S, R30W, Meade County, Kansas.

6. Bore hole dia. 28 in. Completion date 7/30/76
Well depth 380 ft.

7. __ Cable tool __ Rotary __ Driven __ Dug
__ Hollow rod __ Jetted __ Bored X Reverse rotary

8. Use: __ Domestic __ Public supply __ Industry
X Irrigation __ Air conditioning __ Stock
__ Lawn __ Oil field water __ Other

9. Casing: Material stl Height: Above or below
Threaded ___ Welded X Surface 12 in.
RMP ___ PVC ___ Weight 37 lbs./ft.
Dia. 16 in. to 199 ft. depth Wall Thickness: inches or
Dia. ___ in. to ___ ft. depth gage No. .219

10. Screen: Manufacturer's name Foster, Doerr
Type milslot, louver 16"
Slot/gauze 1/8" Length 181'
Set between 199 ft. and 380 ft.
___ ft. and ___ ft.
Gravel pack? yes Size range of material 4.4mm

11. Static water level: not checked mo./day/yr.
___ ft. below land surface Date ___

12. Pumping level below land surfaces: no test
___ ft. after ___ hrs. pumping ___ g.p.m.
___ ft. after ___ hrs. pumping ___ g.p.m.
Estimated maximum yield ___ g.p.m.

13. Water sample submitted: mo./day/yr.
___ Yes X No Date ___

14. Well head completion:
___ Pitless adapter X Inches above grade

15. Well grouted? yes
With: ___ Neat cement X Bentonite ___ Concrete
Depth: From 0 ft. to 10 ft.

16. Nearest source of possible contamination: unk.
ft. ___ Direction ___ Type ___
Well disinfected upon completion? X Yes ___ No

17. Pump: ___ Not installed
Manufacturer's name Layne & Bowler
Model number 14 TL HP ___ Volts ___
Length of drop pipe 280 ft. capacity 2000 g.p.m.
Type:
___ Submersible X Turbine
___ Jet ___ Reciprocating
___ Centrifugal ___ Other

5. Type and color of material	From	To
Top soil	0	4
Tan clay fine sand streaks	4	132
Fine to coarse sand	132	154
Tan clay with sand streaks	154	196
Fine to coarse sand	196	254
Tan clay	254	262
Fine to coarse sand	262	296
Blue clay	296	312
Fine to coarse sand	312	380
Tan sandy clay	380	460
(Use a second sheet if needed)		

18. Elevation:

Topography:
___ Hill
___ Slope
X Upland
___ Valley

19. Remarks:

20. Water well contractor's certification:
This well was drilled under my jurisdiction and this report is true to the best of my knowledge and belief.
Layne-Western Co., Inc. 102
Business name License No.
Address Garden City, Kansas
Signed R L Vincent Date 18 Nov 76
Authorized representative

T 31 R 30 E/W Sec 28 1/4 SE SW SW

Forward the white, blue and pink copies to the Department of Health and Environment

Form WWC-5

MI-1023