

WATER WELL RECORD Form WWC-5


Original Record Correction Change in Well Use

Division of Water Resources App. No. _____

Well ID _____

1 LOCATION OF WATER WELL: Fraction _____ Section Number _____ Township Number _____ Range Number _____
County: _____ $\frac{1}{4}$ $\frac{1}{4}$ $\frac{1}{4}$ $\frac{1}{4}$ T S R E W

2 WELL OWNER: Last Name: _____ First: _____ Street or Rural Address where well is located (if unknown, distance and direction from nearest town or intersection): If at owner's address, check here:
Business: _____
Address: _____
Address: _____
City: _____ State: _____ ZIP: _____

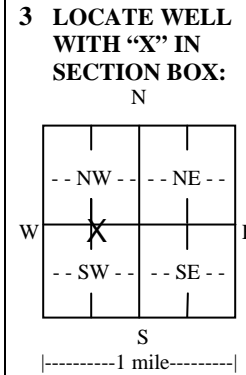

4 DEPTH OF COMPLETED WELL: _____ ft.
Depth(s) Groundwater Encountered: 1) _____ ft.
2) _____ ft. 3) _____ ft., or 4) Dry Well
WELL'S STATIC WATER LEVEL: _____ ft.
 below land surface, measured on (mo-day-yr).....
 above land surface, measured on (mo-day-yr).....
Pump test data: Well water was _____ ft.
after hours pumping _____ gpm
Well water was _____ ft.
after hours pumping _____ gpm
Estimated Yield: _____ gpm
Bore Hole Diameter: _____ in. to _____ ft. and
_____ in. to _____ ft.

5 Latitude:(decimal degrees)
Longitude:(decimal degrees)
Datum: WGS 84 NAD 83 NAD 27
Source for Latitude/Longitude:
 GPS (unit make/model:)
(WAAS enabled? Yes No)
 Land Survey Topographic Map
 Online Mapper:
6 Elevation:ft. Ground Level TOC
Source: Land Survey GPS Topographic Map
 Other

7 WELL WATER TO BE USED AS:

1. Domestic: <input type="checkbox"/> Household <input type="checkbox"/> Lawn & Garden <input type="checkbox"/> Livestock	2. <input type="checkbox"/> Irrigation	3. <input type="checkbox"/> Feedlot	4. <input type="checkbox"/> Industrial	5. <input type="checkbox"/> Public Water Supply: well ID	6. <input type="checkbox"/> Dewatering: how many wells?	7. <input type="checkbox"/> Aquifer Recharge: well ID	8. <input type="checkbox"/> Monitoring: well ID	9. Environmental Remediation: well ID <input type="checkbox"/> Air Sparge <input type="checkbox"/> Soil Vapor Extraction <input type="checkbox"/> Recovery <input type="checkbox"/> Injection	10. <input type="checkbox"/> Oil Field Water Supply: lease	11. Test Hole: well ID <input type="checkbox"/> Cased <input type="checkbox"/> Uncased <input type="checkbox"/> Geotechnical	12. Geothermal: how many bores? a) Closed Loop <input type="checkbox"/> Horizontal <input type="checkbox"/> Vertical b) Open Loop <input type="checkbox"/> Surface Discharge <input type="checkbox"/> Inj. of Water	13. <input type="checkbox"/> Other (specify):
---	--	-------------------------------------	--	--	---	---	---	---	--	---	---	---

Was a chemical/bacteriological sample submitted to KDHE? Yes No If yes, date sample was submitted:
Water well disinfected? Yes No

8 TYPE OF CASING USED: Steel PVC Other **CASING JOINTS:** Glued Clamped Welded Threaded
Casing diameter in. to ft., Diameter in. to ft., Diameter in. to ft.
Casing height above land surface in. Weight lbs./ft. Wall thickness or gauge No.
TYPE OF SCREEN OR PERFORATION MATERIAL:
 Steel Stainless Steel PVC Other (Specify)
 Brass Galvanized Steel None used (open hole)
SCREEN OR PERFORATION OPENINGS ARE:
 Continuous Slot Mill Slot Gauze Wrapped Torch Cut Drilled Holes Other (Specify)
 Louvered Shutter Key Punched Wire Wrapped Saw Cut None (Open Hole)
SCREEN-PERFORATED INTERVALS: From ft. to ft., From ft. to ft., From ft. to ft.
GRAVEL PACK INTERVALS: From ft. to ft., From ft. to ft., From ft. to ft.

9 GROUT MATERIAL: Neat cement Cement grout Bentonite Other
Grout Intervals: From ft. to ft., From ft. to ft., From ft. to ft.
Nearest source of possible contamination: No potential source of contamination within 200 ft.
 Septic Tank Lateral Lines Pit Privy Livestock Pens Insecticide Storage
 Sewer Lines Cess Pool Sewage Lagoon Fuel Storage Abandoned Water Well
 Watertight Sewer Lines Seepage Pit Feedyard Fertilizer Storage Oil Well/Gas Well
 Other (Specify)
Direction from well? Distance from well? ft.

10 FROM	TO	LITHOLOGIC LOG	FROM	TO	LITHO. LOG (cont.) or PLUGGING INTERVALS

11 CONTRACTOR'S OR LANDOWNER'S CERTIFICATION: This water well was constructed, reconstructed, or plugged under my jurisdiction and was completed on (mo-day-year) and this record is true to the best of my knowledge and belief. Kansas Water Well Contractor's License No. This Water Well Record was completed on (mo-day-year) under the business name of

Send one copy to WATER WELL OWNER and retain one for your records. Fee of \$5.00 for each constructed well.
KS Department of Health and Environment, Bureau of Water, Geology Section, 1000 SW Jackson St., Suite 420, Topeka, Kansas 66612-1367. Telephone 785-296-3565.
Visit us at <http://www.kdheks.gov/waterwell/index.html> KSA 82a-1212

Form	WWC5
Contractor	Hydro Resources Mid Continent, Inc. #145
Well Owner	Donald & Bonnie Winter
Doc ID	1533379

Lithology

From	To	LithologicLog
0	2	top soil
2	8	brown sandy clay
8	31	brown sandy clay w/ little caliche mixed
31	39	brown sandy clay w/ caliche & fine sand, some med sand
39	68	white caliche w/ fine sand mixed
68	76	brown & gray sandy clay
76	85	red and little gray sandy clay
85	106	fine to coarse sand
106	124	fine to coarse sand, small gravel
124	135	brown sandy clay
135	210	fine to coarse sand
210	222	brown sandy clay
222	231	blue clay
231	316	fine to caorse sand
316	319	brown sandy clay
319	370	fine to caorse sand
370	381	fine to coarse sand w/ few clay stringers
381	417	fine to coarse sand
417	430	fine to coarse sand, few tight layers

Form	WWC5
Contractor	Hydro Resources Mid Continent, Inc. #145
Well Owner	Donald & Bonnie Winter
Doc ID	1533379

Lithology

From	To	LithologicLog
430	438	fine to coarse sand white & tan sandy clay mixed
438	460	fine sand, lime rock and white clay stringers
460	480	fine sand, few lime rock strips, failrly loose in places
480	507	fine sand w/ few clay stringers
507	525	brown rock & fine sand
525	540	red bed