


1 LOCATION OF WATER WELL: County: **Meade** Fraction **SE 1/4 SE 1/4 NW 1/4** Section Number **10** Township Number **T 31 S** Range Number **R 30 XSW**

Distance and direction from nearest town or city street address of well if located within city?  
**From NE Corner of Plains - 1 Mile East, 6 Miles North, 2,763 Ft. West and 2,840 Ft. North**

2 WATER WELL OWNER: **June Broce**  
 RR#, St. Address, Box #: **P. O. Box 6325 - Sta. B** Board of Agriculture, Division of Water Resources  
 City, State, ZIP Code: **Albuquerque, New Mexico 87197-6325** Application Number: **40,330**

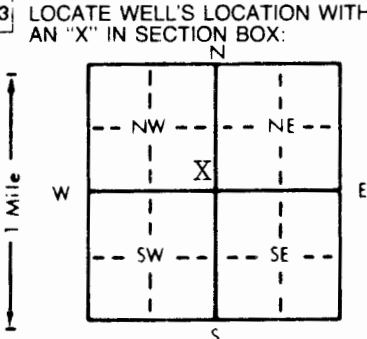

4 DEPTH OF COMPLETED WELL: **405** ft. ELEVATION: \_\_\_\_\_  
 Depth(s) Groundwater Encountered 1. \_\_\_\_\_ ft. 2. \_\_\_\_\_ ft. 3. \_\_\_\_\_ ft.  
 WELL'S STATIC WATER LEVEL: **174 1/2** ft. below land surface measured on **mo/day/yr** **8-20-94**  
 Pump test data: Well water was \_\_\_\_\_ ft. after \_\_\_\_\_ hours pumping \_\_\_\_\_ gpm  
 Est. Yield \_\_\_\_\_ gpm: Well water was \_\_\_\_\_ ft. after \_\_\_\_\_ hours pumping \_\_\_\_\_ gpm  
 Bore Hole Diameter: **30** in. to **405** ft. and \_\_\_\_\_ in. to \_\_\_\_\_ ft.  
 WELL WATER TO BE USED AS: 5 Public water supply 8 Air conditioning 11 Injection well  
 1 Domestic 3 Feedlot 6 Oil field water supply 9 Dewatering 12 Other (Specify below)  
 Irrigation 4 Industrial 7 Lawn and garden only 10 Monitoring well  
 Was a chemical/bacteriological sample submitted to Department? Yes \_\_\_\_\_ No  X; If yes, mo/day/yr sample was submitted \_\_\_\_\_  
 Water Well Disinfected? Yes \_\_\_\_\_ No  X

5 TYPE OF BLANK CASING USED:  Steel 3 RMP (SR) 5 Wrought iron 8 Concrete tile CASING JOINTS: Glued \_\_\_\_\_ Clamped \_\_\_\_\_  
 2 PVC 4 ABS 6 Asbestos-Cement 9 Other (specify below) Welded  X  
 7 Fiberglass \_\_\_\_\_ Threaded \_\_\_\_\_  
 Blank casing diameter: **16** in. to **260** ft. Dia \_\_\_\_\_ in. to \_\_\_\_\_ ft. Dia \_\_\_\_\_ in. to \_\_\_\_\_ ft.  
 Casing height above land surface: **12** in., weight **42.05** lbs./ft. Wall thickness or gauge No. **.250**  
 TYPE OF SCREEN OR PERFORATION MATERIAL: 7 PVC 10 Asbestos-cement  
 Steel 3 Stainless steel 5 Fiberglass 8 RMP (SR) 11 Other (specify) \_\_\_\_\_  
 2 Brass 4 Galvanized steel 6 Concrete tile 9 ABS 12 None used (open hole)  
 SCREEN OR PERFORATION OPENINGS ARE: 5 Gauzed wrapped 8 Saw cut 11 None (open hole)  
 1 Continuous slot  Mill slot  Wire wrapped 9 Drilled holes  
 2 Louvered shutter 4 Key punched 7 Torch cut 10 Other (specify) \_\_\_\_\_  
 SCREEN-PERFORATED INTERVALS: From **260** ft. to **405** ft., From \_\_\_\_\_ ft. to \_\_\_\_\_ ft.  
 From \_\_\_\_\_ ft. to \_\_\_\_\_ ft., From \_\_\_\_\_ ft. to \_\_\_\_\_ ft.  
 GRAVEL PACK INTERVALS: From **20** ft. to **405** ft., From \_\_\_\_\_ ft. to \_\_\_\_\_ ft.  
 From \_\_\_\_\_ ft. to \_\_\_\_\_ ft., From \_\_\_\_\_ ft. to \_\_\_\_\_ ft.

6 GROUT MATERIAL: 1 Neat cement  Cement grout 3 Bentonite 4 Other \_\_\_\_\_  
 Grout Intervals: From **0** ft. to **20** ft., From \_\_\_\_\_ ft. to \_\_\_\_\_ ft., From \_\_\_\_\_ ft. to \_\_\_\_\_ ft.  
 What is the nearest source of possible contamination:  
 1 Septic tank 4 Lateral lines 7 Pit privy 10 Livestock pens 14 Abandoned water well  
 2 Sewer lines 5 Cess pool 8 Sewage lagoon 11 Fuel storage 15 Oil well/Gas well  
 3 Watertight sewer lines 6 Seepage pit 9 Feedyard 12 Fertilizer storage 16 Other (specify below)  
 13 Insecticide storage **NA**  
 Direction from well? \_\_\_\_\_ How many feet? \_\_\_\_\_

FROM	TO	LITHOLOGIC LOG	FROM	TO	PLUGGING INTERVALS
		See attached log			

7 CONTRACTOR'S OR LANDOWNER'S CERTIFICATION: This water well was  (1) constructed, (2) reconstructed, or (3) plugged under my jurisdiction and was completed on (mo/day/year) **8-30-94** and this record is true to the best of my knowledge and belief. Kansas Water Well Contractor's License No. **208** This Water Well Record was completed on (mo/day/yr) **9-7-94** under the business name of **Minter-Wilson Drilling Co., Inc.** by (signature) *Nara Keller*

INSTRUCTIONS Use typewriter or ball point pen PLEASE PRESS FIRMLY and PRINT clearly Please fill in blanks, underline or circle the correct answers. Send top three copies to Kansas Department of Health and Environment, Bureau of Water, Topeka, Kansas 66620-0001. Telephone: 913-296-5545 Send one to WATER WELL OWNER and retain one for your records.

OFFICE USE ONLY T R EW SEC 1/4 1/4 1/4

*The  
Professionals*

# MINTER-WILSON DRILLING CO.

INCORPORATED

Irrigation  
and Domestic  
Water Systems  
Complete Installation  
and Repairing

Phone 276-8269 • P.O. Box A • GARDEN CITY, KANSAS 67846

June Broce  
(Darrell Winfrey-Tenant)  
Meade County  
7-26-94

Location: NW $\frac{1}{4}$  10-31-30  
Copeland - South of second curve  
7 S., 1 $\frac{1}{2}$  E.,  $\frac{1}{2}$  S., 109 Ft. W. & 226 Ft. N.

Static Water Level - About 200'

## Test #1

0' to 2' - Top soil  
01 2' to 23' - Brown clay  
30 23' to 69' - Brown clay white rock mixed  
35 69' to 80' - Brown clay - small gravel strip  
17 80' to 94' - Fine to medium sand and gravel  
04 94' to 115' - Brown sandy clay  
07 115' to 125' - Fine to medium sand  
17 125' to 142' - Fine to medium sand and gravel - loose  
01 142' to 154' - Brown yellow clay mixed  
07 154' to 219' - Fine to medium sand  
01 219' to 233' - Blue clay  
07 233' to 377' - Fine to medium sand  
377' to 385' - Brown sandy clay  
04 385' to 389' - Brown sandy clay - small sand strip  
17 389' to 394' - Fine to medium sand and gravel  
04 394' to 497' - Brown sandy clay  
01 497' to 502' - Brown clay  
19 502' to 515' - Red bed