


WATER WELL RECORD Form WWC-5 KSA 82a-1212

1 LOCATION OF WATER WELL: Fraction NW 1/4 SW 1/4 NW 1/4 Section Number 17 Township Number T 31 S Range Number R 31 W
 COUNTY: 088 SEWARD

Distance and direction from nearest town or city street address of well if located within city?
 FROM KISMET; APPX 3 1/2 MILES NORTH & 1 MILE WEST

2 WATER WELL OWNER: CLAWSON LAND PARTNERSHIP
 RR#, St. Address, Box #: BOX 279 Board of Agriculture, Division of Water Resources
 City, State, ZIP code: PLAINS, KS 67869-0279 Application Number: 18110

3 LOCATE WELL'S LOCATION WITH AN "X" IN SECTION BOX:

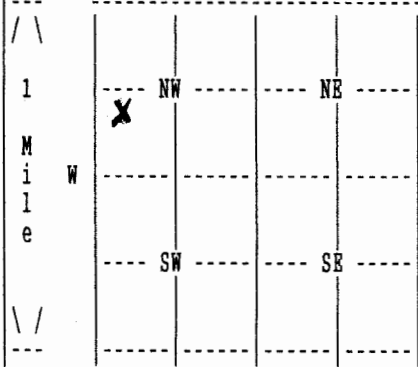

4 DEPTH OF COMPLETED WELL 555 ELEVATION: 0
 Depth(s) Groundwater Encountered 1. 0 ft. 2. 0 ft. 3. 0 ft.

WELL'S STATIC WATER LEVEL 281 ft. below land surface measured on mo/day/yr 11/01/04
 Pump test data: Well water was 408 ft. after 4 hours pumping 685 gpm

Estimated Yield 0 gpm: Well water was 0 ft. after 0 hours pumping 0 gpm

Bore Hole Diameter 24 in. to 555 ft., and in. to 0 ft.

WELL WATER TO BE USED AS: 02 IRRIGATION

Was a chemical/bacteriological sample submitted to department? No ;
 If yes, mo/day/yr sample was submitted Water well disinfected? Yes

5 TYPE OF BLANK CASING USED: 01 STEEL CASING JOINTS: WELDED
 Blank casing diameter 16 in. to 555 ft., Dia in. to 0 ft., Dia in. to 0 ft.
 Casing height above land surface 12 in., weight 42 lbs/ft. Wall thickness or gauge No. .250
 TYPE OF SCREEN OR PERFORATION MATERIAL: 01 STEEL
 SCREEN OR PERFORATION OPENINGS ARE: 01 CONT. SLOT

SCREEN PERFORATED INTERVALS: From 334 ft. to 444 ft., From 0 ft. to 0 ft.
 From 460 ft. to 550 ft., From 0 ft. to 0 ft.
 GRAVEL PACK INTERVALS: From 20 ft. to 555 ft., From 0 ft. to 0 ft.
 From 0 ft. to 0 ft., From 0 ft. to 0 ft.

6 GROUT MATERIAL 03 BENTONITE
 Grout Intervals: From 0 ft. to 20 ft., From 0 ft. to 0 ft., From 0 ft. to 0 ft.
 What is the nearest source of possible contamination: NONE OBSERVED
 Direction from well? How many feet? 0

FROM	TO	LITHOLOGIC LOG	FROM	TO	PLUGGING INTERVALS
0	2	02 SILT			
2	10	04 SANDY CLAY 31 CALICHE 07 FINE SAND			
10	44	01 CLAY 05 SAND 31 CALICHE			
44	53	07 FINE SAND 01 CLAY			
53	77	01 CLAY 20 LIMESTONE			
77	93	01 CLAY 05 SAND			
93	230	05 SAND 11 GRAVEL 01 CLAY			
230	243	01 CLAY			
243	300	05 SAND 01 CLAY			
300	376	05 SAND 01 CLAY 13 FINE GRAVEL			

7 CONTRACTOR'S OR LANDOWNER'S CERTIFICATION: This water well was Constructed under my jurisdiction and was completed on (mo/day/year) 10/28/04 and this record is true to the best of my knowledge and belief. Kansas Water Well Contractor's License No. 145 This Water Well Record was completed on (mo/day/yr) 12/23/04 under the business name of HENKLE DRILLING & SUPPLY by (signature)

1 LOCATION OF WATER WELL: COUNTY: 088 SEWARD	Fraction NW 1/4 SW 1/4 NW 1/4	Section Number 17	Township Number T 31 S	Range Number R 31 W
---	----------------------------------	----------------------	---------------------------	------------------------

2 WATER WELL OWNER: CLAWSON LAND PARTNERSHIP
 RR#, St. Address, Box # : BOX 279
 City, State, ZIP code : PLAINS, KS 67869-0279

Board of Agriculture, Division of Water Resources
 Application Number: 18110

FROM	TO	LITHOLOGIC LOG
376	394	01 CLAY 20 LIMESTONE 05 SAND
394	400	07 FINE SAND 01 CLAY
400	429	07 FINE SAND 08 MEDIUM SAND
429	444	01 CLAY 20 LIMESTONE 05 SAND
444	465	01 CLAY 20 LIMESTONE
465	483	01 CLAY 05 SAND
483	506	06 VERY FN SAND 07 FINE SAND 01 CLAY
506	536	01 CLAY 06 VERY FN SAND
536	550	23 SANDSTONE
550	552	19 SHALE

7 CONTRACTOR'S OR LANDOWNER'S CERTIFICATION: This water well was Constructed under my jurisdiction and was completed on (mo/day/year) 10/28/04 and this record is true to the best of my knowledge and belief. Kansas Water Well Contractor's License No. 145 This Water Well Record was completed on (mo/day/yr) 12/23/04 under the business name of HENKLE DRILLING & SUPPLY by (signature) *Brian J. Rickman*