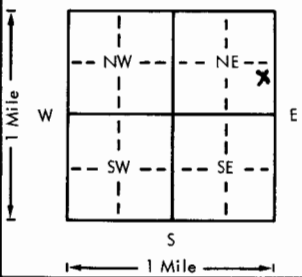


USE TYPEWRITER OR BALL POINT PEN-PRESS FIRMLY, PRINT CLEARLY.

WATER WELL RECORD  
KSA 82a-1201-1215

Kansas Department of Health and Environment-Division of Environment  
(Water well Contractors)  
Topeka, Kansas 66620

1. Location of well:		County <b>Seward</b>	Fraction <b>NE 1/4 SE 1/4 NE 1/4</b>	Section number <b>3</b>	Township number <b>T 31 S R 31</b>	Range number <b>31</b>	E/W
2. Distance and direction from nearest town or city: <b>Approximately 9 mi SE of Sublette, Kansas.</b> Street address of well location if in city:			3. Owner of well: <b>Sherman Ihde</b> R.R. or street: <b>100 East White Wing Drive</b> City, state, zip code: <b>McAllen, Texas 78501</b>				
4. Locate with "X" in section below: 			Sketch map:		6. Bore hole dia. <b>26</b> in. Completion date <b>11/4/77</b> Well depth <b>515</b> ft.		
5. Type and color of material			From		To		7. <input type="checkbox"/> Cable tool <input type="checkbox"/> Rotary <input type="checkbox"/> Driven <input type="checkbox"/> Dug <input type="checkbox"/> Hollow rod <input type="checkbox"/> Jetted <input type="checkbox"/> Bored <input checked="" type="checkbox"/> Reverse rotary
							8. Use: <input type="checkbox"/> Domestic <input type="checkbox"/> Public supply <input type="checkbox"/> Industry <input checked="" type="checkbox"/> Irrigation <input type="checkbox"/> Air conditioning <input type="checkbox"/> Stock <input type="checkbox"/> Lawn <input type="checkbox"/> Oil field water <input type="checkbox"/> Other
See Attachment							9. Casing: Material <b>Steel</b> Height: <b>Above</b> or below Threaded <input type="checkbox"/> Welded <input checked="" type="checkbox"/> Surface <b>12</b> in. RMP <input type="checkbox"/> PVC <input type="checkbox"/> Weight <b>36.9</b> lbs./ft. Dia. <b>16</b> in. to <b>515</b> ft. depth Wall Thickness: inches or Dia. <input type="checkbox"/> in. to <input type="checkbox"/> ft. depth gage No. <b>219</b>
							10. Screen: Manufacturer's name <b>W.A. Brown</b> Type <b>Louvered</b> Dia. <b>16"</b> Slot/gauze <b>.125</b> Length <b>180'</b> Set between <b>273</b> ft. and <b>303</b> ft. <b>343'-443'</b> ft. and <b>463'-513'</b> ft. Gravel pack? <b>Yes</b> Size range of material <b>#1 Coarse</b>
							11. Static water level: <input type="checkbox"/> mo./day/yr. <b>190</b> ft. below land surface Date <b>11/7/77</b>
							12. Pumping level below land surfaces: <b>250</b> ft. after <input type="checkbox"/> hrs. pumping <b>2,000</b> g.p.m. <input type="checkbox"/> ft. after <input type="checkbox"/> hrs. pumping <input type="checkbox"/> g.p.m. Estimated maximum yield <b>2,000</b> g.p.m.
							13. Water sample submitted: <input type="checkbox"/> Yes <input checked="" type="checkbox"/> No Date <input type="checkbox"/>
							14. Well head completion: <input type="checkbox"/> Pitless adapter <b>12</b> Inches above grade
							15. Well grouted? <b>Yes</b> With: <input type="checkbox"/> Neat cement <input checked="" type="checkbox"/> Bentonite <input type="checkbox"/> Concrete Depth: From <b>0</b> ft. to <b>10</b> ft.
							16. Nearest source of possible contamination: <b>None Observed</b> ft. <input type="checkbox"/> Direction <input type="checkbox"/> Type <input type="checkbox"/> Well disinfected upon completion? <input type="checkbox"/> Yes <input checked="" type="checkbox"/> No
							17. Pump: <input checked="" type="checkbox"/> Not installed Manufacturer's name <input type="checkbox"/> Model number <input type="checkbox"/> HP <input type="checkbox"/> Volts <input type="checkbox"/> Length of drop pipe <input type="checkbox"/> ft. capacity <input type="checkbox"/> g.p.m. Type: <input type="checkbox"/> Submersible <input type="checkbox"/> Turbine <input type="checkbox"/> Jet <input type="checkbox"/> Reciprocating <input type="checkbox"/> Centrifugal <input type="checkbox"/> Other
							(Use a second sheet if needed)
18. Elevation:		19. Remarks:					
Topography: <input type="checkbox"/> Hill <input checked="" type="checkbox"/> Slope <input type="checkbox"/> Upland <input type="checkbox"/> Valley		20. Water well contractor's certification: This well was drilled under my jurisdiction and this report is true to the best of my knowledge and belief. <b>Henkle Drilling &amp; Sply 145</b> Business name License No. <input type="checkbox"/> Address <b>Box 639, Garden City, KS</b> Signed <b>Bruce J. Richman</b> Date <b>11/9/77</b> Authorized representative					

Forward the white, blue and pink copies to the Department of Health and Environment

Form WWC-5

