WATER WELL RECORD Form WWC-5 KSA 82a-1212

1 LOCATION OF WATER WELL: County: Seward	Fraction: NW ¼ NW ¼ NE ¼	Section Number: 17	Township Number: T 31 S	Range Number: R 31 E/W

Distance and direction from nearest town or city street address of well if located within city?
6 North and 7 West of Plains, Kansas

2 WATER WELL OWNER: John Jacobs
RR#, St. Address, Box # : Plains, Kansas 67869
City, State, ZIP Code :

Board of Agriculture, Division of Water Resources
Application Number: ----

3 LOCATE WELL'S LOCATION WITH AN "X" IN SECTION BOX:

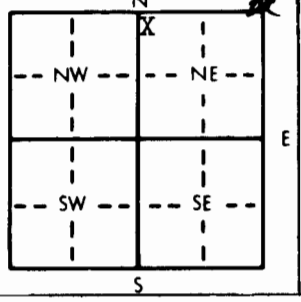

4 DEPTH OF COMPLETED WELL 411 ft. ELEVATION: Upland
Depth(s) Groundwater Encountered 1. Not available ft. 2. ft. 3. ft.
WELL'S STATIC WATER LEVEL 243 ft. below land surface measured on mo/day/yr August 10, 1983
Pump test data: Well water was ft. after hours pumping gpm
Est. Yield 20 gpm: Well water was ft. after hours pumping gpm
Bore Hole Diameter 9 7/8 in. to 411 ft., and in. to ft.
WELL WATER TO BE USED AS: 5 Public water supply 8 Air conditioning 11 Injection well
XX 1 Domestic 3 Feedlot 6 Oil field water supply 9 Dewatering 12 Other (Specify below)
2 Irrigation 4 Industrial 7 Lawn and garden only 10 Observation well
Was a chemical/bacteriological sample submitted to Department? Yes ..... No XX ; If yes, mo/day/yr sample was submitted
Water Well Disinfected? Yes XX No

5 TYPE OF BLANK CASING USED: 5 Wrought iron 8 Concrete tile CASING JOINTS: Glued XX Clamped
1 Steel 3 RMP (SR) 6 Asbestos-Cement 9 Other (specify below) Welded
XX 2 PVC 4 ABS 7 Fiberglass Threaded
Blank casing diameter 5 in. to 371 ft., Dia in. to ft., Dia in. to ft.
Casing height above land surface 12 in., weight 2.8 lbs./ft. Wall thickness or gauge No. .265
TYPE OF SCREEN OR PERFORATION MATERIAL: XX 7 PVC 10 Asbestos-cement
1 Steel 3 Stainless steel 5 Fiberglass 8 RMP (SR) 11 Other (specify)
2 Brass 4 Galvanized steel 6 Concrete tile 9 ABS 12 None used (open hole)
SCREEN OR PERFORATION OPENINGS ARE: 5 Gauzed wrapped XX 8 Saw cut 11 None (open hole)
1 Continuous slot 3 Mill slot 6 Wire wrapped 9 Drilled holes
2 Louvered shutter 4 Key punched 7 Torch cut 10 Other (specify)
SCREEN-PERFORATED INTERVALS: From 371 ft. to 411 ft., From ft. to ft.
From ft. to ft., From ft. to ft.
GRAVEL PACK INTERVALS: From 14 ft. to 411 ft., From ft. to ft.
From ft. to ft., From ft. to ft.

6 GROUT MATERIAL: XX 1 Neat cement 2 Cement grout 3 Bentonite 4 Other
Grout Intervals: From 4 ft. to 14 ft., From ft. to ft., From ft. to ft.
What is the nearest source of possible contamination: NONE
1 Septic tank 4 Lateral lines 7 Pit privy 10 Livestock pens 14 Abandoned water well
2 Sewer lines 5 Cess pool 8 Sewage lagoon 11 Fuel storage 15 Oil well/Gas well
3 Watertight sewer lines 6 Seepage pit 9 Feedyard 12 Fertilizer storage 16 Other (specify below)
13 Insecticide storage
Direction from well? How many feet?

FROM	TO	LITHOLOGIC LOG	FROM	TO	LITHOLOGIC LOG
0	8	0 Top Soil			
8	30	0 Fine Sand			
30	110	0 Sandy Clay			
110	280	1 Med. to Lar. Sand, Gravel w/Clay Streaks			
280	300	Yellow Clay			
300	395	0 Blue Clay			
395	440	0 Med. to Lar. Sand			
440	450	0 Clay			

7 CONTRACTOR'S OR LANDOWNER'S CERTIFICATION: This water well was (1) constructed, (2) reconstructed, or (3) plugged under my jurisdiction and was completed on (mo/day/year) August 10, 1983 and this record is true to the best of my knowledge and belief. Kansas Water Well Contractor's License No. 252 This Water Well Record was completed on (mo/day/yr) October 13, 1983 under the business name of Friesen Windmill & Supply Inc. by (signature)

INSTRUCTIONS: Use typewriter or ball point pen, *PLEASE PRESS FIRMLY* and *PRINT* clearly. Please fill in blanks, underline or circle the correct answers. Send top three copies to Kansas Department of Health and Environment, Division of Environment, Environmental Geology Section, Topeka, KS 66620. Send one to WATER WELL OWNER and retain one for your records.

OFFICE USE ONLY
T 31 R 31 E/W SEC. 17 NW ¼ NW ¼ NE ¼