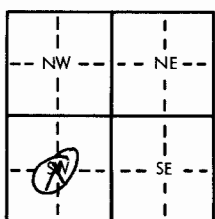
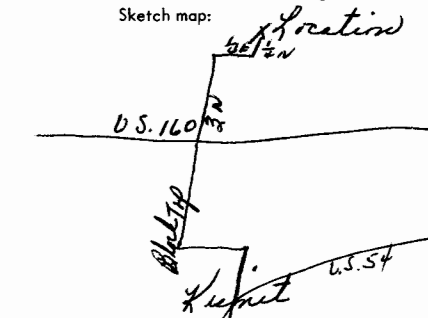


USE TYPEWRITER OR BALL
POINT PEN-PRESS FIRMLY,
PRINT CLEARLY.

WATER WELL RECORD
KSA 82g-1201-1215

Kansas Department of Health and
Environment-Division of Environment
(Water well Contractors)
Topeka, Kansas 66620

| | | | | | | |
|---|--|---|--|---|----------------------------|----------------|
| 1. Location of well: County Seward | | Fraction Center 1/4 1/4 SW 1/4 | Section number 29 | Township number T 31 | Range number S R 31 | E/W E/W |
| 2. Distance and direction from nearest town or city: to Hwy 160, 3N, 1/4 East, 1/2 North. | | | 3. Owner of well: Sage Drilling Company R.R. or street: Box 1450 500 Bitting Bldg. City, state, zip code: Wichita, Kansas 67202 | | | |
| 4. Locate with "X" in section below:  | | Sketch map:  | | 6. Bore hole dia. 9 in. Completion date 2-7-77 Well depth 300 ft. | | |
| 5. Type and color of material | | From | To | 7. <input type="checkbox"/> Cable tool <input checked="" type="checkbox"/> Rotary <input type="checkbox"/> Driven <input type="checkbox"/> Dug <input type="checkbox"/> Hollow rod <input type="checkbox"/> Jetted <input type="checkbox"/> Bored <input type="checkbox"/> Reverse rotary | | |
| | | 8. Use: <input type="checkbox"/> Domestic <input type="checkbox"/> Public supply <input type="checkbox"/> Industry <input type="checkbox"/> Irrigation <input type="checkbox"/> Air conditioning <input type="checkbox"/> Stock <input type="checkbox"/> Lawn <input checked="" type="checkbox"/> Oil field water <input type="checkbox"/> Other | | | | |
| | | 9. Casing: Material <input type="checkbox"/> Height: Above or below Threaded <input type="checkbox"/> Welded <input type="checkbox"/> Surface XXX in. RMP <input type="checkbox"/> PVC <input checked="" type="checkbox"/> Weight 2.78 lbs./ft. Dia. 5 in. to 215 ft. depth Wall Thickness: inches or Dia. 5 in. to 300 ft. depth gage No. 265 | | | | |
| | | 10. Screen: Manufacturer's name sawed Type PVC Dia. 5" Slot/gauze 80 Length 80 Set between 215 ft. and 295 ft. Gravel pack? yes Size range of material 1/8 to | | | | |
| | | 11. Static water level: 185 ft. below land surface Date 2-7-77 | | | | |
| (Use a second sheet if needed) | | From | To | 12. Pumping level below land surfaces: ____ ft. after ____ hrs. pumping ____ g.p.m. ____ ft. after ____ hrs. pumping ____ g.p.m. Estimated maximum yield 60 g.p.m. | | |
| | | 13. Water sample submitted: ____ mo./day/yr. Yes <input checked="" type="checkbox"/> No <input type="checkbox"/> Date ____ | | | | |
| | | 14. Well head completion: 28 inches above grade ____ Pitless adapter | | | | |
| | | 15. Well grouted? yes With: <input checked="" type="checkbox"/> Neat cement <input type="checkbox"/> Bentonite <input type="checkbox"/> Concrete Depth: From 0 ft. to 10 ft. | | | | |
| | | 16. Nearest source of possible contamination: oil well ft. 100 Direction NE Type oil well Well disinfected upon completion? <input checked="" type="checkbox"/> Yes <input type="checkbox"/> No | | | | |
| 18. Elevation: | | 19. Remarks: | | 17. Pump: <input checked="" type="checkbox"/> Not installed Manufacturer's name ____ Model number ____ HP ____ Volts ____ Length of drop pipe ____ ft. capacity ____ g.p.m. Type: <input type="checkbox"/> Submersible <input type="checkbox"/> Turbine <input type="checkbox"/> Jet <input type="checkbox"/> Reciprocating <input type="checkbox"/> Centrifugal <input type="checkbox"/> Other | | |
| | | | | 20. Water well contractor's certification: This well was drilled under my jurisdiction and this report is true to the best of my knowledge and belief. Carlile Water Well 118 Business name License No. ____ Address Box 275, Liberal, Ks. Signed Edward E. Means date 2-18 Authorized representative | | |
| | | | | 21. Topography: <input type="checkbox"/> Hill <input type="checkbox"/> Slope <input checked="" type="checkbox"/> Upland <input type="checkbox"/> Valley | | |
| | | | | | | |
| | | | | | | |

Forward the white, blue and pink copies to the Department of Health and Environment

Form WWC-5