

USE TYPEWRITER OR BALL  
POINT PEN-PRESS FIRMLY,  
PRINT CLEARLY.

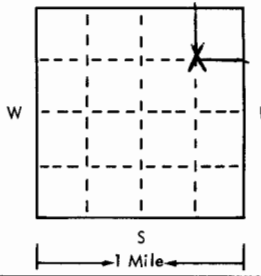
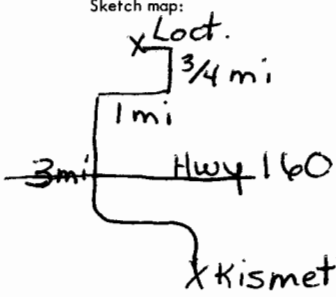
WATER WELL RECORD  
KSA 82a-1201-1215

T R EW sec 1/4 1/4 1/4 No.

Kansas State Dept. Of Health  
(Water Well Contractors)  
Forbes-Bldg. 740  
Topeka, Kansas 66620

Lippoldt

Inv. 10962

1 Location of well:	County <b>Seward</b>	Township name	Fraction <b>C-NE 1/4</b>	Section number <b>29</b>	Town number <b>31S</b>	Range number <b>31W</b>	
Distance and direction from nearest town or city: <b>9 miles North &amp; 1 1/2 West of Kismet, Ks.</b>			3 Owner of well: <b>Sage Drilling Company</b> <b>% Albert Freeman</b> Address: <b>Box 459</b> <b>Liberal, Kansas 67901</b>				
Locate with "X" in section below: 			Sketch map: 			4 Well depth: <b>360</b> ft. Date of completion <b>1-14-75</b> Well diameter <b>9</b> in.	
2 Type and color of material			From		To		
			Surface		0	2	
			Clay		2	47	
			Fine Sand		47	61	
			Clay		61	82	
Small to Medium Sand			82	249	7 Casing: Material <b>PVC</b> Height: above/below Threaded <input type="checkbox"/> Welded <input type="checkbox"/> Surface <input type="checkbox"/> 12 in. Diam. <b>2.78</b> lbs./ft. <b>206</b> 5 1/2 in. to <b>206</b> ft. depth! Drive shoe? <input type="checkbox"/> Yes <input checked="" type="checkbox"/> No 5 1/2 in. to <b>326</b> ft. depth!		
Blue Clay			249	334	8 Screen: Manufacturer <b>Wesco</b> Type <b>PVC</b> Dia. <b>5 1/2</b> Slot/gauze <b>.030</b> Length <b>20</b> Set between <b>206</b> ft. and <b>216</b> ft. Fittings: <b>336</b> <b>346 1/8 to 3/16</b> Gravel pack <input checked="" type="checkbox"/> Yes <input type="checkbox"/> No Size range of material		
Fine Sand, Sandy Blue Clay 50-50			334	360	9 Static water level: <b>190</b> ft. below land surface Date <b>1-14-75</b>		
					10 Pumping level below land surfaces: ft. after hrs. pumping g.p.m. ft. after hrs. pumping g.p.m. Estimated maximum yield <b>50</b> g.p.m.		
					11 Water sample submitted: <input type="checkbox"/> Yes <input checked="" type="checkbox"/> No Date		
					12 Well head completion: <input type="checkbox"/> Pitless adapter <b>12</b> inches above grade		
					13 Well grouted? <input checked="" type="checkbox"/> Yes <input type="checkbox"/> No <input checked="" type="checkbox"/> Neat cement <input checked="" type="checkbox"/> Bentonite <input type="checkbox"/> Depth: From ft. to ft.		
					14 Nearest source of possible contamination: ft. <b>100</b> Direction <b>SW</b> Type <b>Oil</b> Well Well disinfected upon completion? <input checked="" type="checkbox"/> Yes <input type="checkbox"/> No		
					15 Pump: <input checked="" type="checkbox"/> Not installed Manufacturer's name Model number HP Volts Length of drop pipe ft. capacity g.m.p. Type: <input type="checkbox"/> Submersible <input type="checkbox"/> Turbine <input type="checkbox"/> Jet <input type="checkbox"/> Reciprocating <input type="checkbox"/> Centrifugal <input type="checkbox"/> Other		
16 Remarks: elevation  Topography: <input type="checkbox"/> Hill <input type="checkbox"/> Slope <input checked="" type="checkbox"/> Upland <input type="checkbox"/> Valley			17 Water well contractor's certification: This well was drilled under my jurisdiction and this report is true to the best of my knowledge and belief. <b>Carlile Water Well 118</b> Business name License No. Address <b>Box 275, Liberal, Ks.</b> Signed <b>Edward E. Means</b> Date <b>1-21-75</b> Authorized representative				

Forward the white, blue and pink copies to the Kansas State Dept. Of Health.

Form WWC-5