


1] LOCATION OF WATER WELL: County: **Seward** Fraction: **N2 1/4 NW 1/4 SW 1/4** Section Number: **29** Township Number: **T 31 S** Range Number: **R 32 E** **(W)**

Distance and direction from nearest town or city street address of well if located within city?
From Jct. 83 & 160 N. of Liberal 4N., 2E., 1/2S., 1/8E., into

2] WATER WELL OWNER: **OXY** #2 Luther C
 RR#, St. Address, Box #: **Box 300** Board of Agriculture, Division of Water Resources
 City, State, ZIP Code: **Tulsa, Ok. 74102** Application Number: **960282**

3] LOCATE WELL'S LOCATION WITH AN "X" IN SECTION BOX:

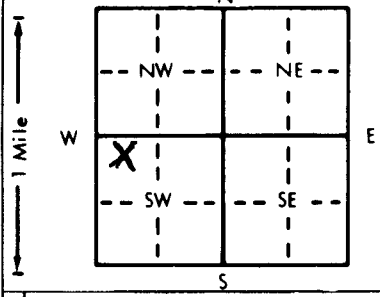

4] DEPTH OF COMPLETED WELL: **500** ft. ELEVATION: _____
 Depth(s) Groundwater Encountered 1. **225** ft. 2. _____ ft. 3. _____ ft.
 WELL'S STATIC WATER LEVEL: **225** ft. below land surface measured on mo/day/yr **8-05-96**
 Pump test data: Well water was **300** ft. after **1** hours pumping **100** gpm
 Est. Yield: **100** gpm; Well water was _____ ft. after _____ hours pumping _____ gpm
 Bore Hole Diameter: **11** in. to **500** ft., and _____ in. to _____ ft.
 WELL WATER TO BE USED AS:
 1 Domestic 3 Feedlot 6 Oil field water supply 9 Dewatering 11 Injection well
 2 Irrigation 4 Industrial 7 Lawn and garden only 10 Monitoring well 12 Other (Specify below) _____
 Was a chemical/bacteriological sample submitted to Department? Yes _____ No ; If yes, mo/day/yr sample was submitted _____
 Water Well Disinfected? Yes No

5] TYPE OF BLANK CASING USED:
 1 Steel 3 RMP (SR) 5 Wrought iron 8 Concrete tile CASING JOINTS: Glued Clamped _____
 2 PVC 4 ABS 6 Asbestos-Cement 9 Other (specify below) _____ Welded _____
 7 Fiberglass Threaded _____
 Blank casing diameter: **6** in. to **500** ft., Dia _____ in. to _____ ft., Dia _____ in. to _____ ft.
 Casing height above land surface: **24** in., weight **2.902** lbs./ft. Wall thickness or gauge No. **.280 SDR 21**

TYPE OF SCREEN OR PERFORATION MATERIAL:
 1 Steel 3 Stainless steel 5 Fiberglass 8 RMP (SR) 10 Asbestos-cement
 2 Brass 4 Galvanized steel 6 Concrete tile 9 ABS 11 Other (specify) _____
 12 None used (open hole) _____

SCREEN OR PERFORATION OPENINGS ARE:
 1 Continuous slot 3 Mill slot 5 Gauzed wrapped 8 Saw cut 11 None (open hole)
 2 Louvered shutter 4 Key punched 6 Wire wrapped 9 Drilled holes
 7 Torch cut 10 Other (specify) _____

SCREEN-PERFORATED INTERVALS: From **420** ft. to **500** ft., From _____ ft. to _____ ft.
 From _____ ft. to _____ ft., From _____ ft. to _____ ft.
 GRAVEL PACK INTERVALS: From **300** ft. to **500** ft., From _____ ft. to _____ ft.
 From _____ ft. to _____ ft., From _____ ft. to _____ ft.

6] GROUT MATERIAL: Neat cement Cement grout Bentonite Other: **Hole Plug**
 Grout Intervals: From **0** ft. to **16** ft., From _____ ft. to _____ ft., From _____ ft. to _____ ft.

What is the nearest source of possible contamination:
 1 Septic tank 4 Lateral lines 7 Pit privy 10 Livestock pens 14 Abandoned water well
 2 Sewer lines 5 Cess pool 8 Sewage lagoon 11 Fuel storage 15 Oil well/Gas well
 3 Watertight sewer lines 6 Seepage pit 9 Feedyard 12 Fertilizer storage 16 Other (specify below) _____
 13 Insecticide storage
 Direction from well? **Southeast** How many feet? **175**

FROM	TO	LITHOLOGIC LOG	FROM	TO	PLUGGING INTERVALS
0	1	Surface			
1	102	Sandy Clay			
102	137	Sand			
137	149	Clay			
149	196	Sand			
196	360	Clay			
360	375	Sand			
375	445	Clay			
445	500	Sand			

7] CONTRACTOR'S OR LANDOWNER'S CERTIFICATION: This water well was constructed, reconstructed, or plugged under my jurisdiction and was completed on (mo/day/year) **8-05-96** and this record is true to the best of my knowledge and belief. Kansas Water Well Contractor's License No. **KWCL - 430**. This Water Well Record was completed on (mo/day/yr) **8-05-96** under the business name of **Howard Drlg, Box 806, Beaver, Ok. 73932** by (signature) _____

INSTRUCTIONS: Use typewriter or ball point pen. PLEASE PRESS FIRMLY and PRINT clearly. Please fill in blanks, underline or circle the correct answers. Send top three copies to Kansas Department of Health and Environment, Bureau of Water, Topeka, Kansas 66620-0001. Telephone: 913-296-5545. Send one to WATER WELL OWNER and retain one for your records.