


1 LOCATION OF WATER WELL: Fraction **(dri) NW NW SW** Section Number **9** Township Number **31** Range Number **32**
 County: **Seward**

Distance and direction from nearest town or city street address of well if located within city?
4 Miles East and 21 Miles North of Liberal

2 WATER WELL OWNER: **Guy W. Lower**
 RR #, St. Address, Box #: **904 S Pursley Box 104** Board of Agriculture, Division of Water Resources
 City, State, ZIP Code: **Sublette, KS 67877** Application Number:

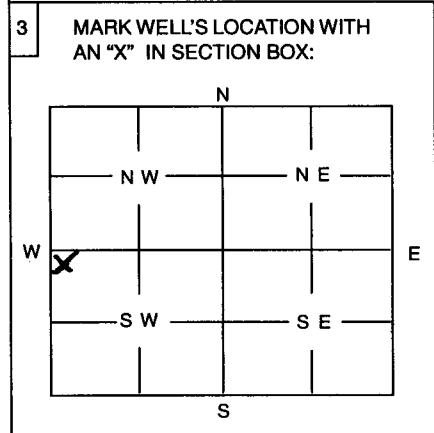

4 DEPTH OF WELL **340** ft
 WELL'S STATIC WATER LEVEL **275** ft
 WELL WAS USED AS:
 1 Domestic 5 Public Water Supply 9 Dewatering
 2 **Irrigation** 6 Oil Field Water Supply 10 Monitoring Well
 3 Feedlot 7 Domestic (Lawn & Garden) 11 Injection Well
 4 Industrial 8 Air Conditioning 12 Other
 Was a chemical / bacteriological sample submitted to Department? Yes No **X**
 If yes, mo/day/yr sample was submitted
 Water Well Disinfected: Yes **X** No

5 TYPE OF BLANK CASING USED:
 1 **Steel** 3 RMP (SR) 5 Wrought 7 Fiberglass 9 Other (Specify below)
 2 PVC 4 ABS 6 Asbestos-Cement 8 Concrete Tile
 Blank casing diameter **16** in. Was casing pulled? Yes No **X** If yes, how much
 Casing height above or below land surface **48** in.

6 GROUT PLUG MATERIAL: 1 Neat cement 2 Cement grout **3 Bentonite** 4 Other
 Grout Plug Intervals: From ft. to ft., From ft. to ft., From to ft.
 What is the nearest source of possible contamination:
 1 Septic tank 6 Seepage pit 11 Fuel storage 16 Other (specify below)
 2 Sewer lines 7 Pit privy **12 Fertilizer storage**
 3 Watertight sewer lines 8 Sewage lagoon 13 Insecticide storage
 4 Lateral lines 9 Feedyard 14 Abandoned water well
 5 Cess Pool 10 Livestock pens 15 Oil well/Gas well
 Direction from well? **N** How many feet? **2,000**

FROM	TO	PLUGGING MATERIALS
340	275	chlorinated Sand
275	10	Clay / Subsoil
10	4	Bentonite
4	-	Cut off casing & Backfill

7 CONTRACTOR'S OR LANDOWNER'S CERTIFICATION: This water well was plugged under my jurisdiction and was completed on (mo/day/year) **7-17-01** and this record is true to the best of my knowledge and belief. Kansas Water Well Contractor's License No. This Water Well Record was completed on (mo/day/year) **7-19-01** under the business name of **Southwest Windmill** by (signature) **David Sma**

INSTRUCTIONS: Use typewriter or ball point pen. Please press firmly and print clearly. Please fill in blanks, underline or circle the correct answers. Send top three copies to Kansas Department of Health and Environment, Bureau of Water, Topeka, Kansas 66620-0001. Telephone: 785/296-3565. Send one to Water Well Owner and retain one for your records.