


## WATER WELL RECORD Form WWC-5 KSA 82a-1212

1 LOCATION OF WATER WELL: COUNTY: 088 SEWARD	Fraction NE 1/4 NE 1/4 SE 1/4	Section Number 03	Township Number T 31 S	Range Number R 32 W
---	----------------------------------	----------------------	---------------------------	------------------------

Distance and direction from nearest town or city street address of well if located within city?  
FROM SUBLETTE; APPX 6 3/4 MILES SOUTH & 5 3/4 MILES EAST

2 WATER WELL OWNER: HINES FARMS RR#, St. Address, Box #: PO BOX 488 City, State, ZIP code: COLBY, KS 67701-0488	Board of Agriculture, Division of Water Resources Application Number: 7,395
---	--

3 LOCATE WELL'S LOCATION WITH  
AN "X" IN SECTION BOX:

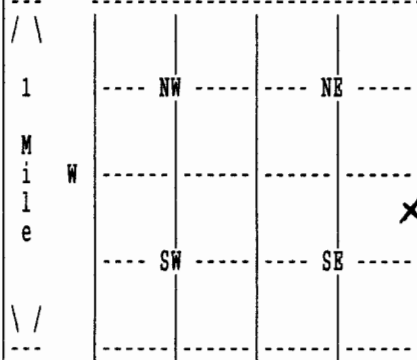

4 DEPTH OF COMPLETED WELL 518 ELEVATION: 0  
Depth(s) Groundwater Encountered 1. 0 ft. 2. 0 ft. 3. 0 ft.

WELL'S STATIC WATER LEVEL 280 ft. below land surface measured on mo/day/yr 04/08/05  
Pump test data: Well water was 107 ft. after 4 hours pumping 598 gpm

Estimated Yield 0 gpm: Well water was 0 ft. after 0 hours pumping 0 gpm

Bore Hole Diameter 24 in. to 518 ft., and in. to 0 ft.

WELL WATER TO BE USED AS: 02 IRRIGATION

Was a chemical/bacteriological sample submitted to department? No;  
If yes, mo/day/yr sample was submitted Water well disinfected? Yes

5 TYPE OF BLANK CASING USED: 01 STEEL CASING JOINTS: WELDED  
Blank casing diameter 16 in. to 518 ft., Dia in. to 0 ft., Dia in. to 0 ft.  
Casing height above land surface 12 in., weight 42 lbs/ft. Wall thickness or gauge No. .250  
TYPE OF SCREEN OR PERFORATION MATERIAL: 01 STEEL  
SCREEN OR PERFORATION OPENINGS ARE: 01 CONT. SLOT

SCREEN PERFORATED INTERVALS:	From 316 ft. to 386 ft., From 0 ft. to 0 ft.
	From 453 ft. to 513 ft., From 0 ft. to 0 ft.
GRAVEL PACK INTERVALS:	From 20 ft. to 518 ft., From 0 ft. to 0 ft.
	From 0 ft. to 0 ft., From 0 ft. to 0 ft.

6 GROUT MATERIAL 03 BENTONITE  
Grout Intervals: From 0 ft. to 20 ft., From 0 ft. to 0 ft., From 0 ft. to 0 ft.  
What is the nearest source of possible contamination: 14 ABAND. WELL  
Direction from well? SOUTH How many feet? 465

FROM	TO	LITHOLOGIC LOG	FROM	TO	PLUGGING INTERVALS
0	2	02 SILT			
2	34	04 SANDY CLAY			
34	40	07 FINE SAND			
40	46	04 SANDY CLAY			
46	53	05 SAND			
53	74	04 SANDY CLAY			
74	165	05 SAND 11 GRAVEL			
165	174	04 SANDY CLAY			
174	190	05 SAND 01 CLAY			
190	195	04 SANDY CLAY			

7 CONTRACTOR'S OR LANDOWNER'S CERTIFICATION: This water well was Constructed under my jurisdiction and was completed on (mo/day/year) 04/02/05 and this record is true to the best of my knowledge and belief. Kansas  
Water Well Contractor's License No. 145 This Water Well Record was completed on (mo/day/yr) 06/16/05  
under the business name of HENKLE DRILLING & SUPPLY by (signature)

(Continued)

WATER WELL RECORD Form WWC-5 KSA 82a-1212

1 LOCATION OF WATER WELL: COUNTY: 088 SEWARD	Fraction NE 1/4 NE 1/4 SE 1/4	Section Number 03	Township Number T 31 S	Range Number R 32 W
---	----------------------------------	----------------------	---------------------------	------------------------

2 WATER WELL OWNER: HINES FARMS

RR#, St. Address, Box # : PO BOX 488

City, State, ZIP code : COLBY, KS 67701-0488

Board of Agriculture, Division of Water Resources

Application Number: 7,395

FROM	TO	LITHOLOGIC LOG
195	211	05 SAND 13 FINE GRAVEL
211	217	04 SANDY CLAY
217	293	05 SAND 13 FINE GRAVEL
293	315	01 CLAY
315	376	05 SAND 11 GRAVEL 01 CLAY
376	386	05 SAND 13 FINE GRAVEL 14 MED GRAVEL
386	450	04 SANDY CLAY 05 SAND
450	471	07 FINE SAND 08 MEDIUM SAND
471	476	04 SANDY CLAY
476	513	23 SANDSTONE
513	520	19 SHALE

7 CONTRACTOR'S OR LANDOWNER'S CERTIFICATION: This water well was Constructed under my jurisdiction and was completed on (mo/day/year) 04/02/05 and this record is true to the best of my knowledge and belief. Kansas

Water Well Contractor's License No. 145

under the business name of HENKLE DRILLING & SUPPLY

This Water Well Record was completed on (mo/day/yr) 06/16/05

by (signature)

*Bern J. Henkle*