


1 LOCATION OF WATER WELL: County: **SEWARD** Fraction: **SE 1/4 NE 1/4 SW 1/4** Section Number: **24** Township Number: **T 31 S** Range Number: **R 33 EW**

Distance and direction from nearest town or city street address of well if located within city?
SUBLETTE, KANSAS - South on Hwy. 83 to SEWARD Co. Line - 3 1/4 mi South + East ->

2 WATER WELL OWNER: **MAI EUBANK** Phone # **316-622-4350**
 RR#, St. Address, Box #: **102 West Ash**
 City, State, ZIP Code: **PROTECTION, KANSAS 67127**
 Board of Agriculture, Division of Water Resources
 Application Number: **960466**

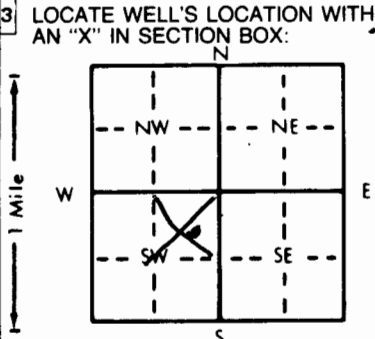

4 DEPTH OF COMPLETED WELL: **460** ft. ELEVATION: _____
 Depth(s) Groundwater Encountered 1. _____ ft. 2. _____ ft. 3. _____ ft.
 WELL'S STATIC WATER LEVEL: **237** ft. below land surface measured on mo/day/yr
 Pump test data: Well water was _____ ft. after _____ hours pumping _____ gpm
 Est. Yield _____ gpm; Well water was _____ ft. after _____ hours pumping _____ gpm
 Bore Hole Diameter: **12 1/4** in. to **18** in., and **10 1/4** in. to **460** ft.
 WELL WATER TO BE USED AS:
 5 Public water supply 8 Air conditioning 11 Injection well
 1 Domestic 3 Feedlot 6 Oil field water supply 9 Dewatering 12 Other (Specify below)
 2 Irrigation 4 Industrial 7 Lawn and garden only 10 Monitoring well
 Was a chemical/bacteriological sample submitted to Department? Yes _____ No **X** If yes, mo/day/yr sample was submitted _____
 Water Well Disinfected? Yes **X** No

5 TYPE OF BLANK CASING USED:
 1 Steel 3 RMP (SR) 5 Wrought iron 8 Concrete tile CASING JOINTS: Glued **X** Clamped _____
 2 PVC 4 ABS 6 Asbestos-Cement 9 Other (specify below) Welded _____
 7 Fiberglass Threaded _____
 Blank casing diameter: **6.56** in. to **380** ft., Dia _____ in. to _____ ft., Dia _____ in. to _____ ft.
 Casing height above land surface: **30** in., weight _____ lbs./ft. Wall thickness or gauge No. **SDR-21**
 TYPE OF SCREEN OR PERFORATION MATERIAL:
 1 Steel 3 Stainless steel 5 Fiberglass 7 PVC 10 Asbestos-cement
 2 Brass 4 Galvanized steel 6 Concrete tile 9 ABS 11 Other (specify) _____
 12 None used (open hole)
 SCREEN OR PERFORATION OPENINGS ARE:
 1 Continuous slot 3 Mill slot .035 5 Gauzed wrapped 8 Saw cut 11 None (open hole)
 2 Louvered shutter 4 Key punched 6 Wire wrapped 9 Drilled holes
 7 Torch cut 10 Other (specify) _____
 SCREEN-PERFORATED INTERVALS: From **380** ft. to **460** ft., From _____ ft. to _____ ft.
 From _____ ft. to _____ ft., From _____ ft. to _____ ft.
 GRAVEL PACK INTERVALS: From **325** ft. to **460** ft., From _____ ft. to _____ ft.
 From _____ ft. to _____ ft., From _____ ft. to _____ ft.

6 GROUT MATERIAL: 1 Neat cement 2 Cement grout 3 Bentonite 4 Other _____
 Grout intervals: From **0** ft. to **12** ft., From **12** ft. to **16** ft., From _____ ft. to _____ ft.
 What is the nearest source of possible contamination: **NONE**
 1 Septic tank 4 Lateral lines 7 Pit privy 10 Livestock pens 14 Abandoned water well
 2 Sewer lines 5 Cess pool 8 Sewage lagoon 11 Fuel storage 15 Oil well/Gas well
 3 Watertight sewer lines 6 Seepage pit 9 Feedyard 12 Fertilizer storage 16 Other (specify below)
 13 Insecticide storage _____
 Direction from well? _____ How many feet? _____

FROM	TO	LITHOLOGIC LOG	FROM	TO	PLUGGING INTERVALS
0	2	Top Soil	287	383	Blue Clay w/ Blue + white sandy clay streaks
2	9	Brown sandy clay			
9	24	Tan sandy clay + Caliche	383	397	Blue clay w/ fine sand streaks
24	97	Brown sandy clay w/ sandstone	397	406	Blue clay
97	141	Coarse sand - small gravel	406	430	Fine sand w/ tan sandy clay
141	147	Brown sandy clay	430	443	Tan clay
147	157	Tan sandy clay + sandstone	443	454	Fine sand
157	163	Yellow clay	454	456	Tan clay
163	167	Sand	456	460	Fine sand
167	172	Yellow clay			
172	205	Sand w/ yellow sandy clay			
205	212	Yellow clay			
212	230	Sand + small gravel			
230	246	Tan clay			
246	287	Tan sandy clay w/ sand streaks			

7 CONTRACTOR'S OR LANDOWNER'S CERTIFICATION: This water well was (1) constructed, (2) reconstructed, or (3) plugged under my jurisdiction and was completed on (mo/day/year) **1-1-97** and this record is true to the best of my knowledge and belief. Kansas Water Well Contractor's License No. **600-A** This Water Well Record was completed on (mo/day/yr) **1-10-97** under the business name of **CRAMER DRIG. Co.** by (signature) **Ray Cramer**

OFFICE USE ONLY
T
R
EW
SEC.