


WATER WELL RECORD Form WWC-5 KSA 82a-1212

1 LOCATION OF WATER WELL: Fraction Section Number Township Number Range Number  
 COUNTY: 088 SEWARD NW 1/4 SW 1/4 SW 1/4 13 T 31 S R 33 W

Distance and direction from nearest town or city street address of well if located within city?  
 FROM SUBLETTE; APPX 8 MILES SOUTH

2 WATER WELL OWNER: TEE, INC.  
 RR#, St. Address, Box # : PO BOX 3450 Board of Agriculture, Division of Water Resources  
 City, State, ZIP code : TAOS, NM 87871-3450 Application Number:

3 LOCATE WELL'S LOCATION WITH AN "X" IN SECTION BOX:

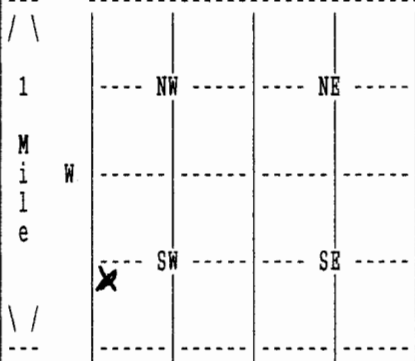

4 DEPTH OF COMPLETED WELL 406 ELEVATION: 0  
 Depth(s) Groundwater Encountered 1. 0 ft. 2. 0 ft. 3. 0 ft.

WELL'S STATIC WATER LEVEL 236 ft. below land surface measured on mo/day/yr 12/14/04  
 Pump test data: Well water was 0 ft. after 0 hours pumping 0 gpm

Estimated Yield 0 gpm: Well water was 0 ft. after 0 hours pumping 0 gpm

Bore Hole Diameter 10 in. to 406 ft., and in. to 0 ft.

WELL WATER TO BE USED AS: 01 DOMESTIC

Was a chemical/bacteriological sample submitted to department? No ;  
 If yes, mo/day/yr sample was submitted Water well disinfected? Yes

5 TYPE OF BLANK CASING USED: 02 PVC CASING JOINTS: GLUED  
 Blank casing diameter 5 in. to 406 ft., Dia in. to 0 ft., Dia in. to 0 ft.  
 Casing height above land surface 12 in., weight 3 lbs/ft. Wall thickness or gauge No. .265  
 TYPE OF SCREEN OR PERFORATION MATERIAL: 07 PVC  
 SCREEN OR PERFORATION OPENINGS ARE: 03 MILL SLOT

SCREEN PERFORATED INTERVALS: From 366 ft. to 406 ft., From 0 ft. to 0 ft.  
 From 0 ft. to 0 ft., From 0 ft. to 0 ft.  
 GRAVEL PACK INTERVALS: From 25 ft. to 406 ft., From 0 ft. to 0 ft.  
 From 0 ft. to 0 ft., From 0 ft. to 0 ft.

6 GROUT MATERIAL 03 BENTONITE  
 Grout Intervals: From 2 ft. to 25 ft., From 0 ft. to 0 ft., From 0 ft. to 0 ft.  
 What is the nearest source of possible contamination: NONE OBSERVED  
 Direction from well? How many feet? 0

FROM	TO	LITHOLOGIC LOG	FROM	TO	PLUGGING INTERVALS
0	2	02 SILT			
2	84	04 SANDY CLAY 07 FINE SAND 20 LIMESTONE			
84	160	05 SAND 13 FINE GRAVEL			
160	176	01 CLAY			
176	187	05 SAND			
187	192	04 SANDY CLAY			
192	203	05 SAND 13 FINE GRAVEL			
203	224	01 CLAY			
224	247	05 SAND			
247	259	01 CLAY 03 SILTY CLAY			

7 CONTRACTOR'S OR LANDOWNER'S CERTIFICATION: This water well was Constructed under my jurisdiction and was completed on (mo/day/year) 12/03/04 and this record is true to the best of my knowledge and belief. Kansas Water Well Contractor's License No. 145 This Water Well Record was completed on (mo/day/yr) 04/14/05 under the business name of HENKLE DRILLING & SUPPLY by (signature)

(Continued)

WATER WELL RECORD Form WWC-5 KSA 82a-1212

1 LOCATION OF WATER WELL:      Fraction      Section Number      Township Number      Range Number  
COUNTY: 088 SEWARD      NW 1/4 SW 1/4 SW 1/4      13      T 31 S      R 33 W

2 WATER WELL OWNER:      TRB, INC.  
RR#, St. Address, Box # : PO BOX 3450      Board of Agriculture, Division of Water Resources  
City, State, ZIP code : TAOS, NM 87871-3450      Application Number:

FROM	TO	LITHOLOGIC LOG
259	273	07 FINE SAND 08 MEDIUM SAND
273	294	04 SANDY CLAY
294	316	05 SAND 01 CLAY
316	328	07 FINE SAND 08 MEDIUM SAND 01 CLAY
328	355	01 CLAY 05 SAND
355	379	05 SAND 13 FINE GRAVEL
379	406	05 SAND 13 FINE GRAVEL

7 CONTRACTOR'S OR LANDOWNER'S CERTIFICATION: This water well was Constructed under my jurisdiction and was completed on (mo/day/year) 12/03/04 and this record is true to the best of my knowledge and belief. Kansas Water Well Contractor's License No. 145      This Water Well Record was completed on (mo/day/yr) 04/14/05  
under the business name of HENKLE DRILLING & SUPPLY      by (signature) *Bruce J. Kiehn*