


WATER WELL RECORD Form WWC-5 KSA 82a-1212

1 LOCATION OF WATER WELL: Fraction Section Number Township Number Range Number  
 COUNTY: 088 SEWARD NW 1/4 SW 1/4 SW 1/4 13 T 31 S R 33 W

Distance and direction from nearest town or city street address of well if located within city?  
 APPROX. 9 MILES SOUTH OF SUBLETTE

2 WATER WELL OWNER: TBB INC Board of Agriculture, Division of Water Resources  
 RR#, St. Address, Box #: PO BOX 3450 Application Number:  
 City, State, ZIP code: TAOS, KS 87871-3450

3 LOCATE WELL'S LOCATION WITH AN "X" IN SECTION BOX:

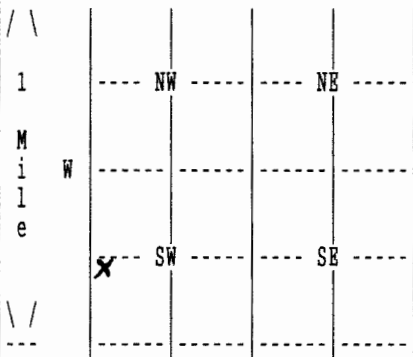

4 DEPTH OF COMPLETED WELL 236 ELEVATION: 0  
 Depth(s) Groundwater Encountered 1. 0 ft. 2. 0 ft. 3. 0 ft.

WELL'S STATIC WATER LEVEL 231 ft. below land surface measured on mo/day/yr 12/14/04  
 Pump test data: Well water was 0 ft. after 0 hours pumping 0 gpm

Estimated Yield 0 gpm: Well water was 0 ft. after 0 hours pumping 0 gpm

Bore Hole Diameter in. to 0 ft., and in. to 0 ft.

WELL WATER WAS: 01 DOMESTIC

Was a chemical/bacteriological sample submitted to department? No ;  
 If yes, mo/day/yr sample was submitted Water well disinfected? Yes

5 TYPE OF BLANK CASING USED: 01 STEEL CASING JOINTS: WELDED  
 Blank casing diameter 5 in. to 236 ft., Dia in. to 0 ft., Dia in. to 0 ft.  
 Casing height above land surface -36 in., weight 0 lbs/ft. Wall thickness or gauge No.  
 TYPE OF SCREEN OR PERFORATION MATERIAL: 01 STEEL  
 SCREEN OR PERFORATION OPENINGS ARE: UNKNOWN

SCREEN PERFORATED INTERVALS: From 0 ft. to 0 ft., From 0 ft. to 0 ft.  
 From 0 ft. to 0 ft., From 0 ft. to 0 ft.  
 GRAVEL PACK INTERVALS: From 0 ft. to 0 ft., From 0 ft. to 0 ft.  
 From 0 ft. to 0 ft., From 0 ft. to 0 ft.

6 GROUT MATERIAL 01 NEAT CEMENT  
 Grout Intervals: From 3 ft. to 236 ft., From 0 ft. to 0 ft., From 0 ft. to 0 ft.  
 What is the nearest source of possible contamination: NONE OBSERVED  
 Direction from well? How many feet? 0

FROM	TO	LITHOLOGIC LOG	FROM	TO	PLUGGING INTERVALS
			0	3	BACKFILL CEMENT
			3	236	
			0	0	
			0	0	
			0	0	
			0	0	
			0	0	
			0	0	
			0	0	
			0	0	

7 CONTRACTOR'S OR LANDOWNER'S CERTIFICATION: This water well was Plugged under my jurisdiction and was completed on (mo/day/year) 12/14/04 and this record is true to the best of my knowledge and belief. Kansas Water Well Contractor's License No. 145 This Water Well Record was completed on (mo/day/yr) 01/05/05 under the business name of HENKLE DRILLING & SUPPLY by (signature) *Bruce Richman*