


WATER WELL RECORD Form WWC-5 KSA 82a-1212

1) LOCATION OF WATER WELL: County: **Seward** Fraction: **Center** $\frac{1}{4}$ **NE** $\frac{1}{4}$ **NW** $\frac{1}{4}$ Section Number: **29** Township Number: **T 31 S** Range Number: **R 33 E(W)**

Distance and direction from nearest town or city street address of well if located within city?
7 miles south & $1\frac{3}{4}$ miles east of Satanta, Haskell Co. Ks.

2) WATER WELL OWNER: **Lewsar, Inc.**
 RR#, St. Address, Box # :
 City, State, ZIP Code : **Satanta, Ks. 67870**
 Board of Agriculture, Division of Water Resources
 Application Number:

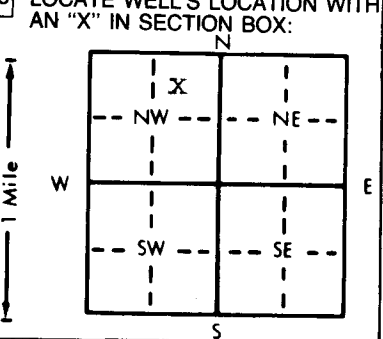

4) DEPTH OF COMPLETED WELL: **400** ft. ELEVATION:
 Depth(s) Groundwater Encountered 1. ft. 2. ft. 3. ft.
 WELL'S STATIC WATER LEVEL .. **185** ... ft. below land surface measured on mo/day/yr .. **11-25-84**.
 Pump test data: Well water was ft. after hours pumping gpm
 Est. Yield .. **60** ... gpm: Well water was ft. after hours pumping gpm
 Bore Hole Diameter .. **10** ... in. to **400** ... ft., and in. to ft.
 WELL WATER TO BE USED AS:
 5 Public water supply 8 Air conditioning 11 Injection well
 1 Domestic 3 Feedlot Oil field water supply 9 Dewatering 12 Other (Specify below)
 2 Irrigation 4 Industrial 7 Lawn and garden only 10 Observation well
 Was a chemical/bacteriological sample submitted to Department? Yes.....No........; If yes, mo/day/yr sample was submitted
 Water Well Disinfected? Yes No

5) TYPE OF BLANK CASING USED:
 1 Steel 3 RMP (SR) 5 Wrought iron 8 Concrete tile CASING JOINTS: Glued Clamped
 PVC 4 ABS 6 Asbestos-Cement 9 Other (specify below) Welded
 7 Fiberglass Threaded
 Blank casing diameter **5** in. to **380** ft., Dia in. to ft., Dia in. to ft.
 Casing height above land surface in., weight lbs./ft. Wall thickness or gauge No. **200** psi.
 TYPE OF SCREEN OR PERFORATION MATERIAL:
 PVC 10 Asbestos-cement
 1 Steel 3 Stainless steel 5 Fiberglass 8 RMP (SR) 11 Other (specify)
 2 Brass 4 Galvanized steel 6 Concrete tile 9 ABS 12 None used (open hole)
 SCREEN OR PERFORATION OPENINGS ARE:
 5 Gauzed wrapped Saw cut 11 None (open hole)
 1 Continuous slot 3 Mill slot 6 Wire wrapped 9 Drilled holes
 2 Louvered shutter 4 Key punched 7 Torch cut 10 Other (specify)
 SCREEN-PERFORATED INTERVALS: From **380** ft. to **400** ft., From ft. to ft.
 GRAVEL PACK INTERVALS: From **10** ft. to **370** ft., From ft. to ft.
 From **380** ft. to **400** ft., From ft. to ft.

6) GROUT MATERIAL: 1 Neat cement 2 Cement grout Bentonite 4 Other
 Grout Intervals: From ... **0** ... ft. to ... **10** ... ft., From ... **370** ... ft. to ... **380** ... ft., From ft. to ft.
 What is the nearest source of possible contamination:
 1 Septic tank 4 Lateral lines 7 Pit privy 10 Livestock pens 14 Abandoned water well
 2 Sewer lines 5 Cess pool 8 Sewage lagoon 11 Fuel storage Oil well/Gas well
 3 Watertight sewer lines 6 Seepage pit 9 Feedyard 12 Fertilizer storage 16 Other (specify below)
 13 Insecticide storage
 Direction from well? How many feet? **75**

FROM	TO	LITHOLOGIC LOG	FROM	TO	LITHOLOGIC LOG
0	2	top soil			
2	60	clay			
60	80	clay, sand & gravel			
80	100	sand & gravel			
100	120	sand & gravel, clay streaks			
120	180	sand & gravel			
180	200	coarse sand			
200	220	sand & gravel			
220	240	fine sand & clay			
240	260	fine to med. sand, clay streaks			
260	280	gravel & sand			
280	350	sand & gravel, clay streaks			
350	365	sand & gravel			
365	400	coarse sand, fine sand, clay streaks			

7) CONTRACTOR'S OR LANDOWNER'S CERTIFICATION: This water well was constructed, (2) reconstructed, or (3) plugged under my jurisdiction and was completed on (mo/day/year) **11-25-84** and this record is true to the best of my knowledge and belief. Kansas Water Well Contractor's License No. **449** This Water Well Record was completed on (mo/day/yr) **8-12-85** under the business name of **Midwest Well & Pump** by (signature) *Arthur Kuhlman*

INSTRUCTIONS: Use typewriter or ball point pen, PLEASE PRESS FIRMLY and PRINT clearly. Please fill in blanks, underline or circle the correct answers. Send top three copies to Kansas Department of Health and Environment, Division of Environment, Environmental Geology Section, Topeka, KS 66620. Send one to WATER WELL OWNER and retain one for your records.