


1 LOCATION OF WATER WELL: Fraction NC 1/4 NC 1/4 C/SE 1/4 Section Number 8 Township Number T 31 S Range Number R 33 EW 9
 County: SEWARD
 Distance and direction from nearest town or city street address of well if located within city?

2 WATER WELL OWNER: FRIESEN WINDMILL AND SUPPLY "BILL HATCHER"
 RR#, St. Address, Box #: BOX M Board of Agriculture, Division of Water Resources
 City, State, ZIP Code: MEADE, KS 67864-0470 ✓ Application Number:

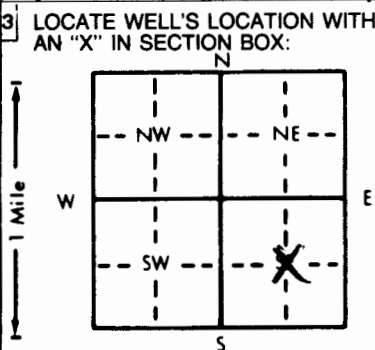

4 DEPTH OF COMPLETED WELL: 420 ft. ELEVATION:
 Depth(s) Groundwater Encountered 1. 245 ft. 2. ft. 3. ft.
 WELL'S STATIC WATER LEVEL: 240 ft. below land surface measured on mo/day/yr 3-25-94
 Pump test data: Well water was 260 ft. after 1 hours pumping 85 gpm
 Est. Yield: 85 gpm; Well water was ft. after hours pumping gpm
 Bore Hole Diameter: 9 1/2 in. to 420 ft., and in. to ft.
 WELL WATER TO BE USED AS:
 1 Domestic 3 Feedlot 6 Oil field water supply 9 Dewatering 12 Other (Specify below)
 2 Irrigation 4 Industrial 7 Lawn and garden only 10 Monitoring well
 Was a chemical/bacteriological sample submitted to Department? Yes No X If yes, mo/day/yr sample was submitted
 Water Well Disinfected? Yes X No

5 TYPE OF BLANK CASING USED:
 1 Steel 3 RMP (SR) 6 Asbestos-Cement 9 Other (specify below) Welded
 2 PVC 4 ABS 7 Fiberglass Threaded
 Blank casing diameter: 5 in. to 420 ft., Dia. in. to ft., Dia. in. to ft.
 Casing height above land surface: 24 in., weight: 2.902 lbs./ft. Wall thickness or gauge No. 265 SDR 21
 TYPE OF SCREEN OR PERFORATION MATERIAL:
 1 Steel 3 Stainless steel 5 Fiberglass 7 PVC 10 Asbestos-cement
 2 Brass 4 Galvanized steel 6 Concrete tile 9 ABS 11 Other (specify)
 12 None used (open hole)
 SCREEN OR PERFORATION OPENINGS ARE:
 1 Continuous slot 3 Mill slot 5 Gauzed wrapped 8 Saw cut 11 None (open hole)
 2 Louvered shutter 4 Key punched 6 Wire wrapped 9 Drilled holes
 7 Torch cut 10 Other (specify)
 SCREEN-PERFORATED INTERVALS: From 340 ft. to 420 ft., From ft. to ft.
 GRAVEL PACK INTERVALS: From 220 ft. to 420 ft., From ft. to ft.

6 GROUT MATERIAL: 1 Neat cement 2 Cement grout 3 Bentonite 4 Other HOLE PLUG
 Grout Intervals: From 1 ft. to 20 ft., From ft. to ft., From ft. to ft.
 What is the nearest source of possible contamination:
 1 Septic tank 4 Lateral lines 7 Pit privy 10 Livestock pens 14 Abandoned water well
 2 Sewer lines 5 Cess pool 8 Sewage lagoon 11 Fuel storage 15 Oil well/Gas well
 3 Watertight sewer lines 6 Seepage pit 9 Feedyard 12 Fertilizer storage 16 Other (specify below)
 13 Insecticide storage
 Direction from well? How many feet?

FROM	TO	LITHOLOGIC LOG	FROM	TO	PLUGGING INTERVALS
0	3	TOP			
3	40	CLAY			
40	120	SANDY CLAY			
120	140	SAND			
140	155	CLAY			
155	202	SNAD & GRAVEL			
202	218	CLAY			
218	225	SAND			
225	260	CLAY			
260	300	SAND			
300	340	CLAY			
340	360	SANDY CLAY			
360	410	SAND			
410	420	CLAY			

7 CONTRACTOR'S OR LANDOWNER'S CERTIFICATION: This water well was (1) constructed, (2) reconstructed, or (3) plugged under my jurisdiction and was completed on (mo/day/year) 3-25-94 and this record is true to the best of my knowledge and belief. Kansas Water Well Contractor's License No. KWWCL-430 This Water Well Record was completed on (mo/day/year) 3-25-94 under the business name of HOWARD DRUG CO. BOX 806 BEAVER, OK 73932 by (signature) *Howard*

INSTRUCTIONS: Use typewriter or ball point pen. PLEASE PRESS FIRMLY and PRINT clearly. Please fill in blanks, underline or circle the correct answers. Send to three copies to Kansas Department of Health and Environment, Bureau of Water, Topeka, Kansas 66620-0001. Telephone: 913-296-5545. Send one to WATER WELL OWNER and retain one for your records.

#18233