


WATER WELL RECORD Form WWC-5 KSA 82a-1212

1 LOCATION OF WATER WELL: County: SEWARD Fraction: SW 1/4 SW 1/4 SW 1/4 Section Number: 33 Township Number: T 31 S Range Number: R 33 E (W)

Distance and direction from nearest town or city street address of well if located within city?
N. EDGE OF SUPREME FEEDERS 2 NORTH, 3/4 WEST NORTH INTO LOC.

2 WATER WELL OWNER: HUGGION ENERGY #1-33 Franz
 RR#, St. Address, Box #: 228 E. WILLIAM STE. 500 Board of Agriculture, Division of Water Resources
 City, State, ZIP Code: WICHITA, KS 67202 Application Number: #940204

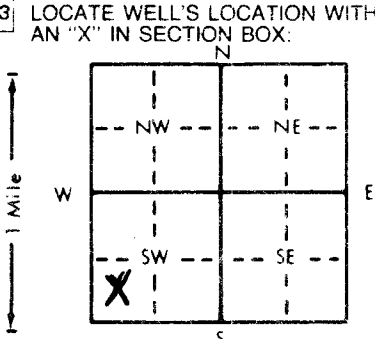

4 DEPTH OF COMPLETED WELL: 360 ft. ELEVATION:
 Depth(s) Groundwater Encountered: 1. 190 ft. 2. _____ ft. 3. _____ ft.
 WELL'S STATIC WATER LEVEL: 190 ft. below land surface measured on mo/day/yr: 5-24-94
 Pump test data: Well water was 210 ft. after 1 hours pumping 100 gpm
 Est. Yield: 100 gpm; Well water was _____ ft. after _____ hours pumping _____ gpm
 Bore Hole Diameter: 11 in. to 360 ft. and _____ in. to _____ ft.
 WELL WATER TO BE USED AS:
 1 Domestic 3 Feedlot 6 Oil field water supply 9 Dewatering 12 Other (Specify below)
 2 Irrigation 4 Industrial 7 Lawn and garden only 10 Monitoring well
 Was a chemical/bacteriological sample submitted to Department? Yes _____ No X; If yes, mo day/yr sample was submitted _____
 Water Well Disinfected? Yes X No _____

5 TYPE OF BLANK CASING USED:
 1 Steel 3 RMP (SR) 5 Wrought iron 8 Concrete tile CASING JOINTS: Glued X Clamped _____
2 PVC 4 ABS 6 Asbestos-Cement 9 Other (specify below) Welded _____
 7 Fiberglass Threaded _____
 Blank casing diameter: 6 in. to 360 ft. Dia. _____ in. to _____ ft. Dia. _____ in. to _____ ft.
 Casing height above land surface: 24 in. weight 2.902 lbs./ft. Wall thickness or gauge No. .316 SDR 21
 TYPE OF SCREEN OR PERFORATION MATERIAL:
 1 Steel 3 Stainless steel 5 Fiberglass 8 RMP (SR) 10 Asbestos-cement 11 Other (specify) _____
 2 Brass 4 Galvanized steel 6 Concrete tile 9 ABS 12 None used (open hole)
 SCREEN OR PERFORATION OPENINGS ARE:
 1 Continuous slot 3 Mill slot 5 Gauzed wrapped 8 Saw cut 11 None (open hole)
 2 Louvered shutter 4 Key punched 6 Wire wrapped 9 Drilled holes
 7 Torch cut 10 Other (specify) _____
 SCREEN-PERFORATED INTERVALS: From 260 ft. to 360 ft. From _____ ft. to _____ ft.
 From _____ ft. to _____ ft. From _____ ft. to _____ ft.
 GRAVEL PACK INTERVALS: From 160 ft. to 360 ft. From _____ ft. to _____ ft.
 From _____ ft. to _____ ft. From _____ ft. to _____ ft.

6 GROUT MATERIAL: 1 Neat cement 2 Cement grout 3 Bentonite 4 Other HOLE PLUG
 Grout Intervals: From _____ ft. to 20 ft. From _____ ft. to _____ ft. From _____ ft. to _____ ft.
 What is the nearest source of possible contamination:
 1 Septic tank 4 Lateral lines 7 Pit privy 10 Livestock pens 14 Abandoned water well
 2 Sewer lines 5 Cess pool 8 Sewage lagoon 11 Fuel storage 15 Oil well/Gas well
 3 Watertight sewer lines 6 Seepage pit 9 Feedyard 12 Fertilizer storage 16 Other (specify below) _____
 13 Insecticide storage
 Direction from well? Southwest How many feet? 100

FROM	TO	LITHOLOGIC LOG	FROM	TO	PLUGGING INTERVALS
0	3	TOP			
3	40	CLAY			
40	60	SANDY CLAY			
60	180	SAND & GRAVEL			
180	200	SAND W/ STREAKS			
200	245	SAND			
245	250	CLAY			
250	355	SAND			
355	360	SANDY CLAY			

7 CONTRACTOR'S OR LANDOWNER'S CERTIFICATION: This water well was (1) constructed, (2) reconstructed, or (3) plugged under my jurisdiction and was completed on (mo/day/yr) 5-24-94 and this record is true to the best of my knowledge and belief. Kansas Water Well Contractor's License No. KWCL -430 This Water Well Record was completed on (mo/day/yr) 5-24-94 under the business name of HOWARD DRIG. CO. BOX 806 BEAVER, OK 73932 by (signature) Ma Howard

INSTRUCTIONS: Use typewriter or ball point pen. PLEASE PRESS FIRMLY and PRINT clearly. Please fill in blanks, underline or circle the correct answers. Send top three copies to Kansas Department of Health and Environment, Bureau of Water, Topeka, Kansas 66620-0001. Telephone: 913-296-5545. Send one to WATER WELL OWNER and retain one for your records.

#18640