


1 LOCATION OF WATER WELL: County: **SEWARD** Fraction: **C 1/4 NE 1/4 NE 1/4** Section Number: **7** Township Number: **T 31 S** Range Number: **R 33W E/W**

Distance and direction from nearest town or city street address of well if located within city?  
**8 MILES NORTH PLEASANT VALLEY, KS.**

2 WATER WELL OWNER: **OKY USA** #2 GUNN "A"  
 RR#, St. Address, Box #: **BOX 26100** Board of Agriculture, Division of Water Resources  
 City, State, ZIP Code: **OKLAHOMA CITY, OK 73126-0100** Application Number: *Any permitted*

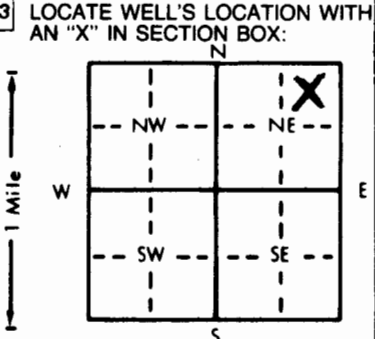

4 DEPTH OF COMPLETED WELL: **420** ft. ELEVATION: \_\_\_\_\_  
 Depth(s) Groundwater Encountered 1. **250** ft. 2. \_\_\_\_\_ ft. 3. \_\_\_\_\_ ft.  
 WELL'S STATIC WATER LEVEL: **250** ft. below land surface measured on mo/day/yr **3-22-95**  
 Pump test data: Well water was **270** ft. after **1** hours pumping **100** gpm  
 Est. Yield: **100** gpm; Well water was \_\_\_\_\_ ft. after \_\_\_\_\_ hours pumping \_\_\_\_\_ gpm  
 Bore Hole Diameter: **11** in. to **420** ft., and \_\_\_\_\_ in. to \_\_\_\_\_ ft.  
 WELL WATER TO BE USED AS:  
 5 Public water supply 8 Air conditioning 11 Injection well  
 1 Domestic 3 Feedlot **6** Oil field water supply 9 Dewatering 12 Other (Specify below)  
 2 Irrigation 4 Industrial 7 Lawn and garden only 10 Monitoring well  
 Was a chemical/bacteriological sample submitted to Department? Yes \_\_\_\_\_ No **X**; If yes, mo/day/yr sample was submitted  
 Water Well Disinfected? Yes **X** No

5 TYPE OF BLANK CASING USED:  
 1 Steel 3 RMP (SR) 5 Wrought iron 8 Concrete tile CASING JOINTS: Glued **X** Clamped \_\_\_\_\_  
**2** PVC 4 ABS 6 Asbestos-Cement 9 Other (specify below) Welded \_\_\_\_\_  
 7 Fiberglass Threaded \_\_\_\_\_  
 Blank casing diameter: **6** in. to **420** ft., Dia \_\_\_\_\_ in. to \_\_\_\_\_ ft., Dia \_\_\_\_\_ in. to \_\_\_\_\_ ft.  
 Casing height above land surface: **24** in., weight **2.902** lbs./ft. Wall thickness or gauge No. **.280 SDR 21**  
 TYPE OF SCREEN OR PERFORATION MATERIAL:  
 1 Steel 3 Stainless steel 5 Fiberglass **7** PVC 10 Asbestos-cement  
 2 Brass 4 Galvanized steel 6 Concrete tile 8 RMP (SR) 11 Other (specify) \_\_\_\_\_  
 12 None used (open hole)  
 SCREEN OR PERFORATION OPENINGS ARE:  
 1 Continuous slot 3 Mill slot 5 Gauzed wrapped **8** Saw cut 11 None (open hole)  
 2 Louvered shutter 4 Key punched 6 Wire wrapped 9 Drilled holes  
 7 Torch cut 10 Other (specify) \_\_\_\_\_  
 SCREEN-PERFORATED INTERVALS: From **360** ft. to **420** ft., From \_\_\_\_\_ ft. to \_\_\_\_\_ ft.  
 From \_\_\_\_\_ ft. to \_\_\_\_\_ ft., From \_\_\_\_\_ ft. to \_\_\_\_\_ ft.  
 GRAVEL PACK INTERVALS: From **320** ft. to **420** ft., From \_\_\_\_\_ ft. to \_\_\_\_\_ ft.  
 From \_\_\_\_\_ ft. to \_\_\_\_\_ ft., From \_\_\_\_\_ ft. to \_\_\_\_\_ ft.

6 GROUT MATERIAL: **1** Neat cement 2 Cement grout 3 Bentonite **4** Other **HOLE PLUG**  
 Grout Intervals: From **1** ft. to **20** ft., From \_\_\_\_\_ ft. to \_\_\_\_\_ ft., From \_\_\_\_\_ ft. to \_\_\_\_\_ ft.  
 What is the nearest source of possible contamination:  
 1 Septic tank 4 Lateral lines 7 Pit privy 10 Livestock pens 14 Abandoned water well  
 2 Sewer lines 5 Cess pool 8 Sewage lagoon 11 Fuel storage **15** Oil well/Gas well  
 3 Watertight sewer lines 6 Seepage pit 9 Feedyard 12 Fertilizer storage 16 Other (specify below)  
 13 Insecticide storage  
 Direction from well? *Southeast* How many feet? **165**

FROM	TO	LITHOLOGIC LOG	FROM	TO	PLUGGING INTERVALS
0	3	TOP			
3	108	SANDY CLAY W/SAND			
108	152	SAND			
152	168	SAND & GRAVEL			
168	189	CLAY W/SAND STREAKS			
189	264	SAND & GRAVEL			
264	285	SANDY CLAY			
285	326	SAND & SANDY CLAY			
326	368	SAND & GRAVEL			
368	410	SAND & GRAVEL W/BLUE & YELLOW			
410	420	SAND & GRAVEL			

7 CONTRACTOR'S OR LANDOWNER'S CERTIFICATION: This water well was **(1)** constructed, (2) reconstructed, or (3) plugged under my jurisdiction and was completed on (mo/day/year) **3-22-95** and this record is true to the best of my knowledge and belief. Kansas Water Well Contractor's License No. **KWCL-430** This Water Well Record was completed on (mo/day/yr) **3-22-95** under the business name of **HOWARD DRILG. CO. BOX 806 BEAVER, OK 73932** by (signature) *[Signature]*

INSTRUCTIONS: Use typewriter or ball point pen. PLEASE PRESS FIRMLY and PRINT clearly. Please fill in blanks, underline or circle the correct answers. Send top three copies to Kansas Department of Health and Environment, Bureau of Water, Topeka, Kansas 66620-0001. Telephone: 913-296-5545. Send one to WATER WELL OWNER and retain one for your records.

OFFICE USE ONLY T R E W SEC.