


LOCATION OF WATER WELL: County: **SEWARD** Fraction: **N2 1/4 SE 1/4 SE 1/4** Section Number: **25** Township Number: **T 31S S** Range Number: **R 34W E/W**

Distance and direction from nearest town or city street address of well if located within city?
FROM SUPREME FEEDERS: 4 NORTH, 3 WEST TO STEEL GATE, 3/4 SOUTHWEST & NORTH INTO LOC.

WATER WELL OWNER: **OXY USA INC.** #2 BEATY "B"
 RR#, St. Address, Box #: **P.O. BOX 26100** Board of Agriculture, Division of Water Resources
 City, State, ZIP Code: **OKLAHOMA CITY, OK 73126-0100** Application Number: *Oxy Permitted*

LOCATE WELL'S LOCATION WITH AN "X" IN SECTION BOX:

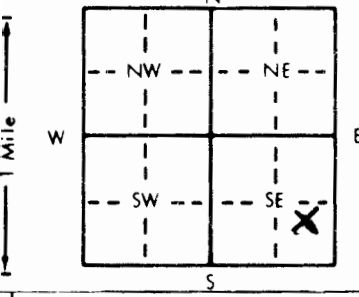

DEPTH OF COMPLETED WELL: **360** ft. ELEVATION:
 Depth(s) Groundwater Encountered 1. ft. 2. ft. 3. **4-12-95**
 WELL'S STATIC WATER LEVEL: **190** ft. below land surface measured on mo/day/yr
 Pump test data: Well water was ft. after hours pumping gpm
 Est. Yield gpm: Well water was ft. after hours pumping gpm
 Bore Hole Diameter in. to ft. and in. to ft.
 WELL WATER USED AS:
 1 Domestic ~~X~~ WAS 3 Feedlot 5 Public water supply 8 Air conditioning 11 Injection well
 2 Irrigation 4 Industrial 7 Lawn and garden only 10 Monitoring well 12 Other (Specify below)
 Was a chemical/bacteriological sample submitted to Department? Yes No; If yes, mo/day/yr sample was submitted
 Water Well Disinfected? Yes No

TYPE OF BLANK CASING USED:
 1 Steel 3 RMP (SR) 5 Wrought iron 8 Concrete tile CASING JOINTS: Glued Clamped
 2 PVC 4 ABS 7 Fiberglass Threaded
 Blank casing diameter: **5** in. to **360** ft., Dia in. to ft., Dia in. to ft.
 Casing height above land surface: **5' BELOW** in., weight lbs./ft. Wall thickness or gauge No.

TYPE OF SCREEN OR PERFORATION MATERIAL:
 1 Steel 3 Stainless steel 5 Fiberglass 8 RMP (SR) 11 Other (specify)
 2 Brass 4 Galvanized steel 6 Concrete tile 9 ABS 12 None used (open hole)
 SCREEN OR PERFORATION OPENINGS ARE:
 1 Continuous slot 3 Mill slot 5 Gauzed wrapped 8 Saw cut 11 None (open hole)
 2 Louvered shutter 4 Key punched 7 Torch cut 10 Other (specify)

SCREEN-PERFORATED INTERVALS: From ft. to ft., From ft. to ft.
 GRAVEL PACK INTERVALS: From ft. to ft., From ft. to ft.

6 GROUT MATERIAL: 1 Neat cement 2 Cement grout 3 Bentonite 4 Other
 Grout Intervals: From **8** ft. to **5** ft. From ft. to ft. From ft. to ft.
 What is the nearest source of possible contamination:
 1 Septic tank 4 Lateral lines 7 Pit privy 10 Livestock pens 14 Abandoned water well
 2 Sewer lines 5 Cess pool 8 Sewage lagoon 11 Fuel storage 15 Oil well/Gas well
 3 Watertight sewer lines 6 Sewage pit 9 Feedyard 12 Fertilizer storage 16 Other (specify below)
 13 Insecticide storage
 Direction from well? *Southeast* How many feet? **210**

FROM	TO	LITHOLOGIC LOG	FROM	TO	PLUGGING INTERVALS
			360	185	CHLORINATED GRAVEL
			185	170	HOLE PLUG
			170	5	CEMENT GROUT
			5	0	BACKFILL

7 CONTRACTOR'S OR LANDOWNER'S CERTIFICATION: This water well was (1) constructed, (2) reconstructed, or (3) plugged under my jurisdiction and was completed on (mo/day/year) **3-9-95** and this record is true to the best of my knowledge and belief. Kansas Water Well Contractor's License No. **KWWCL-430** This Water Well Record was completed on (mo/day/yr) **4-12-95** under the business name of **HOWARD DRLG.CO.BOX 806 BEAVER,OK 73932** by (signature) *Howard Drlg Co*

INSTRUCTIONS: Use typewriter or ball point pen. PLEASE PRESS FIRMLY and PRINT clearly. Please fill in blanks, underline or circle the correct answers. Send top three copies to Kansas Department of Health and Environment, Bureau of Water, Topeka, Kansas 66620-0001. Telephone: 913-296-5545. Send one to WATER WELL OWNER and retain one for your records.