


1 LOCATION OF WATER WELL: Fraction WC $\frac{1}{4}$ SE $\frac{1}{4}$ SW $\frac{1}{4}$ Section Number 5 Township Number T 31 S Range Number R 34 EW
 County: Seward

Distance and direction from nearest town or city street address of well if located within city?
5 Miles Est, 1 mile South, 1/2 mi. East, 1/4 Mile North

2 WATER WELL OWNER: Betty Young Murfin Drilling, Inc.
 RR#, St. Address, Box #: Rt. 1 Box 661
 City, State, ZIP Code: MOSCOW, Ks. 67952 Colby, Ks. 67701
 Board of Agriculture, Division of Water Resources
 Application Number: 950183

3 LOCATE WELL'S LOCATION WITH AN "X" IN SECTION BOX:

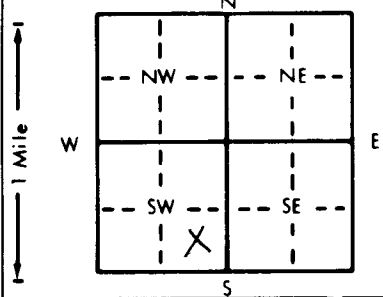

4 DEPTH OF COMPLETED WELL: 312 ft. ELEVATION: ft.
 Depth(s) Groundwater Encountered 1. ft. 2. ft. 3. ft.
 WELL'S STATIC WATER LEVEL: 165 ft. below land surface measured on mo/day/yr
 Pump test data: Well water was ft. after hours pumping gpm
 Est. Yield gpm: Well water was ft. after hours pumping gpm
 Bore Hole Diameter: 8 in. to 312 ft., and in. to ft.
 WELL WATER TO BE USED AS:
 5 Public water supply 8 Air conditioning 11 Injection well
 1 Domestic 3 Feedlot 6 Oil field water supply 9 Dewatering 12 Other (Specify below)
 2 Irrigation 4 Industrial 7 Lawn and garden only 10 Monitoring well
 Was a chemical/bacteriological sample submitted to Department? Yes.....No...X.....; If yes, mo/day/yr sample was submitted
 Water Well Disinfected? Yes No X

5 TYPE OF BLANK CASING USED:
 1 Steel 3 RMP (SR) 5 Wrought iron 8 Concrete tile CASING JOINTS: Glued .. X .. Clamped
 2 PVC 4 ABS 6 Asbestos-Cement 9 Other (specify below) Welded
 7 Fiberglass Threaded.....
 Blank casing diameter: 4.5 in. to 272 ft., Dia in. to ft., Dia in. to ft.
 Casing height above land surface: 18 in., weight 2.38 lbs./ft. Wall thickness or gauge No. 248

TYPE OF SCREEN OR PERFORATION MATERIAL:
 1 Steel 3 Stainless steel 5 Fiberglass 8 RMP (SR) 10 Asbestos-cement 11 Other (specify)
 2 Brass 4 Galvanized steel 6 Concrete tile 9 ABS 12 None used (open hole)

SCREEN OR PERFORATION OPENINGS ARE:
 1 Continuous slot 3 Mill slot 5 Gauzed wrapped 8 Saw cut 11 None (open hole)
 2 Louvered shutter 4 Key punched 6 Wire wrapped 9 Drilled holes
 7 Torch cut 10 Other (specify)

SCREEN-PERFORATED INTERVALS: From 272 ft. to 312 ft., From ft. to ft.
 From ft. to ft., From ft. to ft.
 GRAVEL PACK INTERVALS: From 20 ft. to 312 ft., From ft. to ft.
 From ft. to ft., From ft. to ft.

6 GROUT MATERIAL: 1 Neat cement 2 Cement grout 3 Bentonite 4 Other
 Grout Intervals: From 0 ft. to 20 ft., From ft. to ft., From ft. to ft.

What is the nearest source of possible contamination:
 1 Septic tank 4 Lateral lines 7 Pit privy 10 Livestock pens 14 Abandoned water well
 2 Sewer lines 5 Cess pool 8 Sewage lagoon 11 Fuel storage 15 Oil well/Gas well
 3 Watertight sewer lines 6 Seepage pit 9 Feedyard 12 Fertilizer storage 16 Other (specify below)
 13 Insecticide storage
 Direction from well? SW How many feet? 200'

FROM	TO	LITHOLOGIC LOG	FROM	TO	PLUGGING INTERVALS
0	6	Surface	125	147	Med. Sand & Gravel w/some tight Strks.
6	33	Med. Coarse Sand & Gravel			
33	37	Sandy Clay w/Cemented Sand	147	158	Sandy Clay
37	39	Med. Coarse Sand w/Clay STRK & Sandstone	158	180	Med. Sand w/Gravel
39	63	Med. Coarse Sand w/Rocks & Clay Strks.	180	200	Med. Sand & Gravel w/Clay St.
63	68	Chirt	200	205	Sandy Clay
68	74	Fine Med. Sand	205	240	Med. Sand w/Clay Strks.
74	78	Chirt	240	245	Sandy Clay
78	87	Med. to Coarse Sand w/Gravel	245	250	Med. Sand
87	100	Churt & Med. Sand Strks.	250	255	Sandy Clay
100	105	Med. Sand & Gravel	255	312	Med. Sand w/a few Fine Clay Layers
105	115	Churt & Cemented Sand			
115	125	Med. Sand & Gravel			

7 CONTRACTOR'S OR LANDOWNER'S CERTIFICATION: This water well was (1) constructed, (2) reconstructed, or (3) plugged under my jurisdiction and was completed on (mo/day/year) 7-1-95 and this record is true to the best of my knowledge and belief. Kansas Water Well Contractor's License No. 554 This Water Well Record was completed on (mo/day/yr) 7-3-95 under the business name of Woofter Pump & Well, Inc. by (signature) Julye Woofter

INSTRUCTIONS: Use typewriter or ball point pen. PLEASE PRESS FIRMLY and PRINT clearly. Please fill in blanks, underline or circle the correct answers. Send top three copies to Kansas Department of Health and Environment, Bureau of Water, Topeka, Kansas 66620-0001. Telephone: 913-296-5545. Send one to WATER WELL OWNER and retain one for your records.