


1 LOCATION OF WATER WELL: Fraction Section Number Township Number Range Number

Distance and direction from nearest town or city street address of well if located within city?
 FROM SATANTA, KS. 3 SOUTH, 1 1/2 WEST AND 1/2 MILES SOUTH

2 WATER WELL OWNER: DAVIS, CLARENCE
 REF, St. Address, Box #: ROUTE 2 -- BOX 57A Board of Agriculture, Division of Water Resources
 City, State, ZIP code: SATANTA, KS 67870- Application Number:

3 LOCATE WELL'S LOCATION WITH AN "X" IN SECTION BOX:

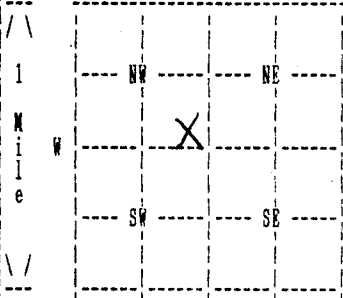

4 DEPTH OF COMPLETED WELL 307 ELEVATION: 0
 Depth(s) Groundwater Encountered 1. 0 ft. 2. 0 ft. 3. 0 ft.

WELL'S STATIC WATER LEVEL 170 ft. below land surface measured on mo/day/yr 09/07/95
 Pump test data: Well water was 0 ft. after 0 hours pumping 0 gpm

Estimated Yield 50 gpm: Well water was 0 ft. after 0 hours pumping 0 gpm

Bore Hole Diameter 9 in. to 307 ft., and in. to 0 ft.

WELL WATER TO BE USED AS: DOMESTIC

Was a chemical/bacteriological sample submitted to department? No ;
 If yes, mo/day/yr sample was submitted Water well disinfected? Yes

5 TYPE OF BLANK CASING USED: PVC CASING JOINTS: GLUED
 Blank casing diameter 5 in. to 307 ft., Dia in. to 0 ft., Dia in. to 0 ft.
 Casing height above land surface 12 in., weight 200 lbs/ft. Wall thickness or gauge No. 21
 TYPE OF SCREEN OR PERFORATION MATERIAL: PVC
 SCREEN OR PERFORATION OPENINGS ARE: SAW CUT

SCREEN PERFORATED INTERVALS: From 262 ft. to 302 ft., From 0 ft. to 0 ft.
 From 0 ft. to 0 ft., From 0 ft. to 0 ft.
 GRAVEL PACK INTERVALS: From 60 ft. to 307 ft., From 0 ft. to 0 ft.
 From 0 ft. to 0 ft., From 0 ft. to 0 ft.

6 GROUT MATERIAL BENTONITE
 Grout Intervals: From 0 ft. to 60 ft., From 0 ft. to 0 ft., From 0 ft. to 0 ft.
 What is the nearest source of possible contamination: ABANDONED WELL
 Direction from well? SOUTH How many feet? 15

FROM	TO	LITHOLOGIC LOG	FROM	TO	PLUGGING INTERVALS
0	30	TOPSOIL FINE SAND			
30	160	COARSE SAND GRAVEL			
160	225	MED-COARSE SAND GRAVEL			
225	240	MEDIUM SAND			
240	245	FINE SAND			
245	300	MED-COARSE SAND GRAVEL			
300	307	CALACHIE CLAY			

7 CONTRACTOR'S OR LANDOWNER'S CERTIFICATION: This water well was constructed under my jurisdiction and was completed on (mo/day/year) 09/07/95 and this record is true to the best of my knowledge and belief. Kansas Water Well Contractor's License No. 179 This Water Well Record was completed on (mo/day/yr) 09/19/95 under the business name of JOE'S WELL SERVICE, INC. by (signature) *Joseph Critch*