


1 LOCATION OF WATER WELL: Fraction SW 1/4 NE 1/4 NW 1/4 Section Number 26 Township Number T 31S S Range Number R 34W EW

Distance and direction from nearest town or city street address of well if located within city?
 15 MILES NORTHWEST OF ARKALON, KS

2 WATER WELL OWNER: OXY, U.S.A. #2 FEDERAL LAND BANK "A"
 RR#, St. Address, Box #: BOX26100 Board of Agriculture, Division of Water Resources
 City, State, ZIP Code: OKLAHOMA CITY, OKLA. 73126 Application Number: OXY permits

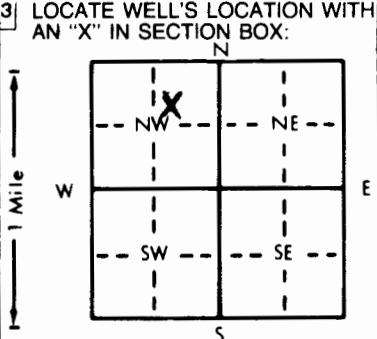

4 DEPTH OF COMPLETED WELL: 340 ft. ELEVATION: ... ft.
 Depth(s) Groundwater Encountered: 1. 190 ft. 2. ... ft. 3. ... ft.
 WELL'S STATIC WATER LEVEL: 190 ft. below land surface measured on mo/day/yr 07-30-93
 Pump test data: Well water was 205 ft. after 1 hours pumping 100 gpm
 Est. Yield: 100 gpm; Well water was ... ft. after ... hours pumping ... gpm
 Bore Hole Diameter: 9 1/2 in. to 340 ft., and ... in. to ... ft.
 WELL WATER TO BE USED AS:
 5 Public water supply 8 Air conditioning 11 Injection well
 1 Domestic 3 Feedlot 6 Oil field water supply 9 Dewatering 12 Other (Specify below)
 2 Irrigation 4 Industrial 7 Lawn and garden only 10 Monitoring well
 Was a chemical/bacteriological sample submitted to Department? Yes ... No. X; If yes, mo/day/yr sample was submitted
 Water Well Disinfected? Yes X No

5 TYPE OF BLANK CASING USED:
 1 Steel 3 RMP (SR) 5 Wrought iron 8 Concrete tile CASING JOINTS: Glued X Clamped
 2 PVC 4 ABS 6 Asbestos-Cement 9 Other (specify below) Welded
 7 Fiberglass Threaded
 Blank casing diameter: 5 in. to 340 ft., Dia. ... in. to ... ft., Dia. ... in. to ... ft.
 Casing height above land surface: 24 in., weight 2.902 lbs./ft. Wall thickness or gauge No. 280 SDR 21
 TYPE OF SCREEN OR PERFORATION MATERIAL:
 1 Steel 3 Stainless steel 5 Fiberglass 7 PVC 8 RMP (SR) 10 Asbestos-cement
 2 Brass 4 Galvanized steel 6 Concrete tile 9 ABS 11 Other (specify) 12 None used (open hole)
 SCREEN OR PERFORATION OPENINGS ARE:
 1 Continuous slot 3 Mill slot 5 Gauzed wrapped 8 Saw cut 11 None (open hole)
 2 Louvered shutter 4 Key punched 6 Wire wrapped 9 Drilled holes
 7 Torch cut 10 Other (specify)
 SCREEN-PERFORATED INTERVALS: From ... ft. to ... ft., From ... ft. to ... ft.
 GRAVEL PACK INTERVALS: From 240 ft. to 340 ft., From ... ft. to ... ft.

6 GROUT MATERIAL: 1 Heat cement 2 Cement grout 3 Bentonite 4 Other HOLE PLUG
 Grout Intervals: From ... ft. to 20 ft., From ... ft. to ... ft., From ... ft. to ... ft.
 What is the nearest source of possible contamination:
 1 Septic tank 4 Lateral lines 7 Pit privy 10 Livestock pens 14 Abandoned water well
 2 Sewer lines 5 Cess pool 8 Sewage lagoon 11 Fuel storage 15 Oil well/Gas well
 3 Watertight sewer lines 6 Seepage pit 9 Feedyard 12 Fertilizer storage 16 Other (specify below)
 13 Insecticide storage
 Direction from well? SOUTHWEST How many feet? 120

FROM	TO	LITHOLOGIC LOG	FROM	TO	PLUGGING INTERVALS
0	3	BROWN CLAY			
3	6	SAND			
6	116	SMALL GR & PEA GR			
116	121	TAN CLAY			
121	143	SAND & GRAVEL			
143	148	GRAVEL W/ CLAY STREAKS			
148	152	SAND			
152	188	SAND & SMALL GRAVEL			
188	192	CLAY			
192	238	SAND			
238	245	CLAY			
245	328	SMALL GRAVEL			
328	340	TAN BLUE CLAY			

7 CONTRACTOR'S OR LANDOWNER'S CERTIFICATION: This water well was (1) constructed, (2) reconstructed, or (3) plugged under my jurisdiction and was completed on (mo/day/year) 07-30-93 and this record is true to the best of my knowledge and belief. Kansas Water Well Contractor's License No. KWCL-430 This Water Well Record was completed on (mo/day/yr) 07-30-93 under the business name of HOWARD DRIG. CO. BOX 806 BEAVER, OKLA. 73928 (signature)

INSTRUCTIONS: Use typewriter or ball point pen. PLEASE PRESS FIRMLY and PRINT clearly. Please fill in blanks, underline or circle the correct answers. Send two copies to Kansas Department of Health and Environment, Bureau of Water, Topeka, Kansas 66620-0001. Telephone: 913-296-5545. Send one to WATER WELL OWNER and retain one for your records.