


1 LOCATION OF WATER WELL: Fraction NW 1/4 SE 1/4 SE 1/4 Section Number 22 Township Number T 31 S Range Number R 34w EW  
 County: SEWARD

Distance and direction from nearest town or city street address of well if located within city?

2 WATER WELL OWNER: ANADARKO PETR. CORP. **CONOVER B-2**  
 RR#, St. Address, Box # : P.O. BOX 351 Board of Agriculture, Division of Water Resources  
 City, State, ZIP Code : LIBERAL KS 67905-0351 Application Number: 960073

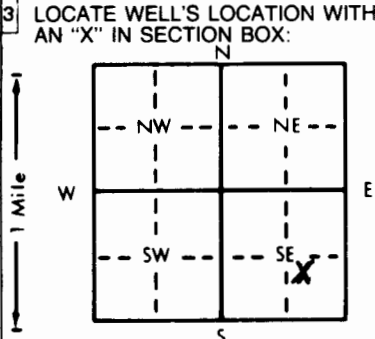

4 DEPTH OF COMPLETED WELL 300 ft. ELEVATION: \_\_\_\_\_  
 Depth(s) Groundwater Encountered 1. 170 ft. 2. \_\_\_\_\_ ft. 3. \_\_\_\_\_ ft.  
 WELL'S STATIC WATER LEVEL 170 ft. below land surface measured on mo/day/yr 02-17-96  
 Pump test data: Well water was 190 ft. after 1 hours pumping 100 gpm  
 Est. Yield 100 gpm: Well water was \_\_\_\_\_ ft. after \_\_\_\_\_ hours pumping \_\_\_\_\_ gpm  
 Bore Hole Diameter 11 in. to 300 ft., and \_\_\_\_\_ in. to \_\_\_\_\_ ft.  
 WELL WATER TO BE USED AS: 5 Public water supply 8 Air conditioning 11 Injection well  
 1 Domestic 3 Feedlot 6 Oil field water supply 9 Dewatering 12 Other (Specify below)  
 2 Irrigation 4 Industrial 7 Lawn and garden only 10 Monitoring well  
 Was a chemical/bacteriological sample submitted to Department? Yes \_\_\_\_\_ No X; If yes, mo/day/yr sample was submitted \_\_\_\_\_  
 Water Well Disinfected? Yes X No \_\_\_\_\_

5 TYPE OF BLANK CASING USED: 5 Wrought iron 8 Concrete tile CASING JOINTS: Glued X Clamped \_\_\_\_\_  
 1 Steel 3 RMP (SR) 6 Asbestos-Cement 9 Other (specify below) Welded \_\_\_\_\_  
2 PVC 4 ABS 7 Fiberglass \_\_\_\_\_ Threaded \_\_\_\_\_  
 Blank casing diameter 24 in. to 300 ft., Dia. \_\_\_\_\_ in. to \_\_\_\_\_ ft., Dia. \_\_\_\_\_ in. to \_\_\_\_\_ ft.  
 Casing height above land surface 24 in., weight 2,902 lbs./ft. Wall thickness or gauge No. 280 SDR 21  
 TYPE OF SCREEN OR PERFORATION MATERIAL: 7 PVC 10 Asbestos-cement  
 1 Steel 3 Stainless steel 5 Fiberglass 8 RMP (SR) 11 Other (specify) \_\_\_\_\_  
 2 Brass 4 Galvanized steel 6 Concrete tile 9 ABS 12 None used (open hole)  
 SCREEN OR PERFORATION OPENINGS ARE: 5 Gauzed wrapped 8 Saw cut 11 None (open hole)  
 1 Continuous slot 3 Mill slot 6 Wire wrapped 9 Drilled holes  
 2 Louvered shutter 4 Key punched 7 Torch cut 10 Other (specify) \_\_\_\_\_  
 SCREEN-PERFORATED INTERVALS: From 260 ft. to 300 ft., From \_\_\_\_\_ ft. to \_\_\_\_\_ ft.  
 From \_\_\_\_\_ ft. to \_\_\_\_\_ ft., From \_\_\_\_\_ ft. to \_\_\_\_\_ ft.  
 GRAVEL PACK INTERVALS: From 160 ft. to 300 ft., From \_\_\_\_\_ ft. to \_\_\_\_\_ ft.  
 From \_\_\_\_\_ ft. to \_\_\_\_\_ ft., From \_\_\_\_\_ ft. to \_\_\_\_\_ ft.

6 GROUT MATERIAL: 1 Neat cement 2 Cement grout 3 Bentonite 4 Other **HOLE PLUG**  
 Grout intervals: From 0 ft. to 16 ft., From \_\_\_\_\_ ft. to \_\_\_\_\_ ft., From \_\_\_\_\_ ft. to \_\_\_\_\_ ft.  
 What is the nearest source of possible contamination:  
 1 Septic tank 4 Lateral lines 7 Pit privy 10 Livestock pens 14 Abandoned water well  
 2 Sewer lines 5 Cess pool 8 Sewage lagoon 11 Fuel storage 15 Oil well/Gas well  
 3 Watertight sewer lines 6 Seepage pit 9 Feedyard 12 Fertilizer storage 16 Other (specify below)  
 13 Insecticide storage  
 Direction from well? South How many feet? 150

| FROM | TO  | LITHOLOGIC LOG | FROM | TO | PLUGGING INTERVALS |
|------|-----|----------------|------|----|--------------------|
| 0    | 2   | TOP SOIL       |      |    |                    |
| 2    | 16  | TAN CLAY       |      |    |                    |
| 16   | 30  | COARSE SAND    |      |    |                    |
| 30   | 60  | GRAVEL         |      |    |                    |
| 60   | 98  | COARSE SAND    |      |    |                    |
| 98   | 100 | TAN CLAY       |      |    |                    |
| 100  | 220 | SAND & GRAVEL  |      |    |                    |
| 220  | 223 | TAN CLAY       |      |    |                    |
| 223  | 300 | SAND & GRAVEL  |      |    |                    |

7 CONTRACTOR'S OR LANDOWNER'S CERTIFICATION: This water well was (1) constructed, (2) reconstructed, or (3) plugged under my jurisdiction and was completed on (mo/day/year) 02-17-96 and this record is true to the best of my knowledge and belief. Kansas Water Well Contractor's License No. KWWCL-430. This Water Well Record was completed on (mo/day/yr) 02-17-96 under the business name of HOWARD DRUG CO. BOX 806 BEAVER, OK 73932 by (signature) \_\_\_\_\_

INSTRUCTIONS: Use typewriter or ball point pen. PLEASE PRESS FIRMLY and PRINT clearly. Please fill in blanks, underline or circle the correct answers. Send top three copies to Kansas Department of Health and Environment, Bureau of Water, Topeka, Kansas 66620-0001. Telephone: 913-296-5545. Send one to WATER WELL OWNER and retain one for your records.

OFFICE USE ONLY  
T  
R  
EW  
SEC.