


1 LOCATION OF WATER WELL: County: Seward Fraction: NE 1/4 NE 1/4 SW 1/4 Section Number: 4 Township Number: 31 Range Number: 34 E/W: W

Distance and direction from nearest town or city street address of well if located within city?

4 Miles South & 3 Miles West of Satanta

2 WATER WELL OWNER: Cattle Empire Global Positioning Systems (decimal degrees, min. of 4 digits)
 RR#, St. Address, Box #: Rt. 1 Box 109-A Latitude: _____
 City, State ZIP Code: Satanta, KS 67870 Longitude: _____
 Elevation: _____
 Datum: _____
 Data Collection Method: _____

3 MARK WELL'S LOCATION WITH AN "X" IN SECTION BOX:

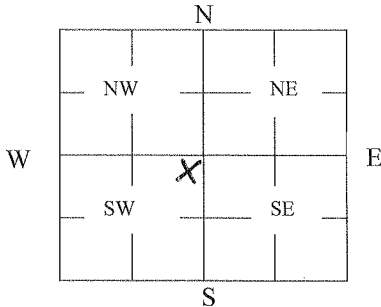

4 DEPTH OF WELL 94 ft.

WELL'S STATIC WATER LEVEL Dry ft.

WELL WAS USED AS:

- | | | |
|--|---|--|
| <input checked="" type="checkbox"/> 1 Domestic | <input type="checkbox"/> 5 Public Water Supply | <input type="checkbox"/> 9 Dewatering |
| <input type="checkbox"/> 2 Irrigation | <input type="checkbox"/> 6 Oil Field Water Supply | <input type="checkbox"/> 10 Monitoring |
| <input type="checkbox"/> 3 Feedlot | <input type="checkbox"/> 7 Domestic (Lawn & Garden) | <input type="checkbox"/> 11 Injection Well |
| <input type="checkbox"/> 4 Industrial | <input type="checkbox"/> 8 Air Conditioning | <input type="checkbox"/> 12 Other _____ |

Was a chemical/bacteriological sample submitted to Department? Yes _____ No

5 TYPE OF BLANK CASING USED:
 1 Steel 3 RMP (SR) 5 Wrought 7 Fiberglass 9 Other (Specify below)
 2 PVC 4 ABS 6 Asbestos-Cement 8 Concrete Tile

Blank casing diameter 5 in. Was casing pulled? Yes _____ No If yes, how much _____
 Casing height above or below land surface 36 in.

6 GROUT PLUG MATERIAL: 1 Neat cement 2 Cement grout 3 Bentonite 4 Other _____

Grout Plug Intervals: From _____ ft. to _____ ft., From _____ ft. to _____ ft., From _____ to _____ ft.

What is the nearest source of possible contamination:

- | | | | |
|---|--|--|---|
| <input type="checkbox"/> 1 Septic tank | <input type="checkbox"/> 6 Seepage pit | <input type="checkbox"/> 11 Fuel Storage | <input type="checkbox"/> 16 Other (specify below) |
| <input type="checkbox"/> 2 Sewer lines | <input type="checkbox"/> 7 Pit privy | <input type="checkbox"/> 12 Fertilizer storage | _____ |
| <input type="checkbox"/> 3 Watertight sewer lines | <input type="checkbox"/> 8 Sewage lagoon | <input type="checkbox"/> 13 Insecticide storage | _____ |
| <input type="checkbox"/> 4 Lateral lines | <input type="checkbox"/> 9 Feedyard | <input type="checkbox"/> 14 Abandoned water well | Direction from well? <u>SE</u> |
| <input type="checkbox"/> 5 Cess pool | <input type="checkbox"/> 10 Livestock pens | <input checked="" type="checkbox"/> 15 Oil well/Gas well | How many feet? <u>750</u> |

FROM	TO	PLUGGING MATERIALS	FROM	TO	PLUGGING MATERIALS
<u>94</u>	<u>6</u>	<u>Clay/Subsoil</u>			
<u>6</u>	<u>3</u>	<u>Bentonite</u>			
<u>3</u>	<u>-</u>	<u>Cut off casing & backfill</u>			

7 CONTRACTOR'S OR LANDOWNER'S CERTIFICATION: This water well was plugged under my jurisdiction and was completed on (mo/day/year) 5-27-11 and this record is true to the best of my knowledge and belief. Kansas Water Well Contractor's License No. 805. This Water Well Record was completed on (mo/day/year) 6-8-11 under the business name of Southwest Windmill by (signature) David Ems

INSTRUCTIONS: Use typewriter or ballpoint pen. Please press firmly and print clearly. Please fill in blanks, underline or circle the correct answers. Send top three copies to Kansas Department of Health and Environment, Bureau of Water, Geology Section, 1000 SW Jackson St., Ste. 420, Topeka, Kansas 66612-1367. Telephone: 785/296-5522. Send one to Water Well Owner and retain one for your records. Visit us at <http://www.kdheks.gov/geo/waterwells>.