USE TYPEWRITER OR BALL POINT PEN-PRESS FIRMLY, PRINT CLEARLY.

WATER WELL RECORD
KSA 82a-1201-1215

Kansas Department of Health and Environment-Division of Environment
(Water well Contractors)
Topeka, Kansas 66620

1. Location of well:	County: Seward	Fraction: NE SE NW	Section number: 4	Township number: T 31 S	Range number: R 34 W

X Distance and direction from nearest town or city: 9½ E. - 3½ N.
Street address of well location if in city: Moscow

3. Owner of well: Marvin Harlow
R.R. or street: Satanta, Kansas 67870
City, state, zip code:

4. Locate with "X" in section below:

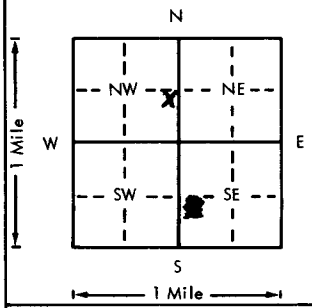

Sketch map:

6. Bore hole dia. 9 7/8 in. Completion date
Well depth 134 ft. 6-24-76

7. __ Cable tool X Rotary __ Driven __ Dug
__ Hollow rod __ Jetted __ Bored __ Reverse rotary

8. Use: X Domestic __ Public supply __ Industry
__ Irrigation __ Air conditioning __ Stock
__ Lawn __ Oil field water __ Other

9. Casing: Material PVC Height: Above or below
Threaded ___ Welded ___ Surface 12 in.
RMP ___ PVC ___ Weight 403 lbs./ft. 100
Dia. 6 in. to 134 ft. depth Wall Thickness: inches or
Dia. ___ in. to ___ ft. depth gage No. .316

5. Type and color of material	From	To
Top soil	0	12
Clay	13	33
Med. to lar. sand & gravel	34	75
Med. to lar. sand	76	134

(Use a second sheet if needed)

10. Screen: Manufacturer's name
Jess & Lowell
Type PVC Dia. 6"
Slot/gauze 1/8" Length 50'
Set between 84 ft. and 134 ft.
___ ft. and ___ ft.
Gravel pack? yes Size range of material 3/16"

11. Static water level: mo./day/yr.
59 ft. below land surface Date 6/1/76

12. Pumping level below land surfaces:
___ ft. after ___ hrs. pumping ___ g.p.m.
___ ft. after ___ hrs. pumping ___ g.p.m.
Estimated maximum yield ___ g.p.m.

13. Water sample submitted: mo./day/yr.
__ Yes X No Date

14. Well head completion:
X Pitless adapter 12 Inches above grade

15. Well grouted? yes
With: ___ Neat cement ___ Bentonite X Concrete
Depth: From 4 ft. to 14 ft.

16. Nearest source of possible contamination: none
ft. ___ Direction ___ Type
Well disinfected upon completion? X Yes ___ No

17. Pump: ___ Not installed
Manufacturer's name Aermotor
Model number SD19 HP 1 Volts 220
Length of drop pipe 105 ft. capacity 20 g.p.m.
Type:
XX Submersible ___ Turbine
___ Jet ___ Reciprocating
___ Centrifugal ___ Other

18. Elevation:

Topography:
___ Hill
___ Slope
___ Upland
X Valley

19. Remarks:

20. Water well contractor's certification:
This well was drilled under my jurisdiction and this report is true to the best of my knowledge and belief.
Friesen Windmill 252
Business name License No.
Address Meade, Kansas 67864
Signed [signature] Date 6-28-76
Authorized representative

31 T 34 R W 4 Sec NESEN 1/4 1/4 1/4 1/4

Forward the white, blue and pink copies to the Department of Health and Environment

Form WWC-5

M1-1023