


1 LOCATION OF WATER WELL: County: Seward Fraction: S 1/2 1/4 SE 1/4 NE 1/4 Section Number: 7 Township Number: T 31 S Range Number: R 34 EW

Distance and direction from nearest town or city street address of well if located within city? 16 1/2 miles N of Pleasant Valley, KS

2 WATER WELL OWNER: Sweetman Drilling Co. RR#, St. Address, Box #: 110 S Main, #500 City, State, ZIP Code: Wichita, KS 67202 #1-7 Rooney-B Board of Agriculture, Division of Water Resources Application Number: 910411

3 LOCATE WELL'S LOCATION WITH AN "X" IN SECTION BOX:

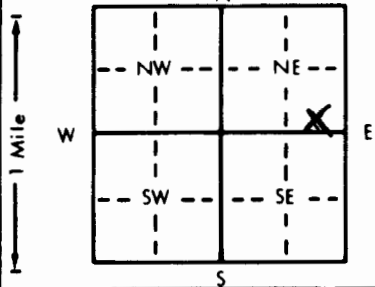

4 DEPTH OF COMPLETED WELL: 290 ft. ELEVATION:

Depth(s) Groundwater Encountered: 1. 140 ft. 2. ft. 3. ft. WELL'S STATIC WATER LEVEL: 140 ft. below land surface measured on mo/day/yr 09-05-91 Pump test data: Well water was 155 ft. after 1 hours pumping 120 gpm Est. Yield 120 gpm: Well water was ft. after hours pumping gpm Bore Hole Diameter: 11 in. to 290 ft. and in. to ft. WELL WATER TO BE USED AS: 5 Public water supply 8 Air conditioning 11 Injection well 1 Domestic 3 Feedlot 6 Oil field water supply 9 Dewatering 12 Other (Specify below) 2 Irrigation 4 Industrial 7 Lawn and garden only 10 Monitoring well Was a chemical/bacteriological sample submitted to Department? Yes No X; If yes, mo/day/yr sample was submitted Water Well Disinfected? Yes X No

5 TYPE OF BLANK CASING USED: 1 Steel 2 PVC 3 RMP (SR) 4 ABS 5 Wrought iron 6 Asbestos-Cement 7 Fiberglass 8 Concrete tile 9 Other (specify below) CASING JOINTS: Glued X Clamped Welded Threaded

Blank casing diameter: 6 in. to 290 ft. Dia. in. to ft. Dia. in. to ft. Casing height above land surface: 24 in., weight lbs./ft. Wall thickness or gauge No. .032

TYPE OF SCREEN OR PERFORATION MATERIAL: 1 Steel 2 Brass 3 Stainless steel 4 Galvanized steel 5 Fiberglass 6 Concrete tile 7 PVC 8 RMP (SR) 9 ABS 10 Asbestos-cement 11 Other (specify) 12 None used (open hole)

SCREEN OR PERFORATION OPENINGS ARE: 1 Continuous slot 2 Louvered shutter 3 Mill slot 4 Key punched 5 Gauzed wrapped 6 Wire wrapped 7 Torch cut 8 Saw cut 9 Drilled holes 11 None (open hole) 10 Other (specify)

SCREEN-PERFORATED INTERVALS: From 210 ft. to 290 ft. From ft. to ft. From ft. to ft. GRAVEL PACK INTERVALS: From 90 ft. to 290 ft. From ft. to ft. From ft. to ft.

6 GROUT MATERIAL: 1 Neat cement 2 Cement grout 3 Bentonite 4 Other Hole plug Grout Intervals: From 1 ft. to 20 ft. From ft. to ft. From ft. to ft.

What is the nearest source of possible contamination: 1 Septic tank 2 Sewer lines 3 Watertight sewer lines 4 Lateral lines 5 Cess pool 6 Seepage pit 7 Pit privy 8 Sewage lagoon 9 Feedyard 10 Livestock pens 11 Fuel storage 12 Fertilizer storage 13 Insecticide storage 14 Abandoned water well 15 Oil well/Gas well 16 Other (specify below)

Direction from well? Northwest How many feet? 140

Table with columns: FROM, TO, LITHOLOGIC LOG, FROM, TO, PLUGGING INTERVALS. Rows show depth intervals and lithology: 0-18 Sandy Clay, 18-268 Sand and Gravel, 268-286 Sandy Clay, 286-290 Clay.

7 CONTRACTOR'S OR LANDOWNER'S CERTIFICATION: This water well was (1) constructed, (2) reconstructed, or (3) plugged under my jurisdiction and was completed on (mo/day/year) 09-05-91 and this record is true to the best of my knowledge and belief. Kansas Water Well Contractor's License No. KWWCL-430 This Water Well Record was completed on (mo/day/yr) 09-05-91 under the business name of Howard Drlg. Co. Box 806 Beaver, OK 73932 by (signature)

INSTRUCTIONS: Use typewriter or ball point pen. PLEASE PRESS FIRMLY and PRINT clearly. Please fill in blanks, underline or circle the correct answers. Send top three copies to Kansas Department of Health and Environment, Bureau of Water, Topeka, Kansas 66620-0001. Telephone: 913-296-5545. Send one to WATER WELL OWNER and retain one for your records.