


1 LOCATION OF WATER WELL: County: Seward Fraction: SW 1/4 SW 1/4 SE 1/4 Section Number: 10 Township Number: T 31 S Range Number: R 34 E 10

Distance and direction from nearest town or city street address of well if located within city?
5 1/2 South, 1 1/4 West from Satanta

2 WATER WELL OWNER: Rolland Jacquart
 RR#, St. Address, Box #: _____ Board of Agriculture, Division of Water Resources
 City, State, ZIP Code: Sublette, Kansas 67877 Application Number: _____

3 LOCATE WELL'S LOCATION WITH AN "X" IN SECTION BOX:

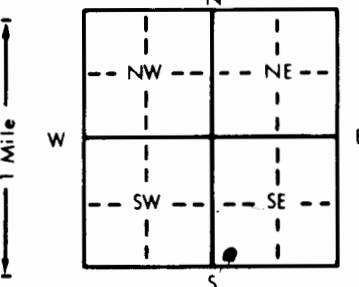

4 DEPTH OF COMPLETED WELL: 300 ft. ELEVATION: _____
 Depth(s) Groundwater Encountered 1. _____ ft. 2. _____ ft. 3. _____ ft.
 WELL'S STATIC WATER LEVEL: 230 ft. below land surface measured on mo/day/yr 11-14-83
 Pump test data: Well water was 230 ft. after 1 1/2 hours pumping 15 gpm
 Est. Yield 25 gpm; Well water was _____ ft. after _____ hours pumping _____ gpm
 Bore Hole Diameter: 8 3/8 in. to _____ ft., and _____ in. to _____ ft.
 WELL WATER TO BE USED AS:
 Domestic 3 Feedlot 6 Oil field water supply 9 Dewatering 12 Other (Specify below)
 1 Steel 2 Irrigation 4 Industrial 7 Lawn and garden only 10 Observation well
 Was a chemical/bacteriological sample submitted to Department? Yes _____ No X; If yes, mo/day/yr sample was submitted _____
 Water Well Disinfected? Yes _____ No X

5 TYPE OF BLANK CASING USED:
 1 Steel 3 RMP (SR) 6 Asbestos-Cement 9 Other (specify below) Welded
 2 PVC 4 ABS 7 Fiberglass _____ Threaded
 Blank casing diameter: 5 in. to 260 ft., Dia _____ in. to _____ ft., Dia _____ in. to _____ ft.
 Casing height above land surface: 24 in., weight 200 lbs/ft. Wall thickness or gauge No. _____

TYPE OF SCREEN OR PERFORATION MATERIAL:
 1 Steel 3 Stainless steel 5 Fiberglass 8 RMP (SR) 10 Asbestos-cement
 2 Brass 4 Galvanized steel 6 Concrete tile 9 ABS 11 Other (specify) _____
 12 None used (open hole)

SCREEN OR PERFORATION OPENINGS ARE:
 1 Continuous slot 3 Mill slot 5 Gauzed wrapped 8 Saw cut 11 None (open hole)
 2 Louvered shutter 4 Key punched 6 Wire wrapped 9 Drilled holes
 7 Torch cut 10 Other (specify) _____

SCREEN-PERFORATED INTERVALS: From 260 ft. to 300 ft., From _____ ft. to _____ ft.
 GRAVEL PACK INTERVALS: From 15 ft. to 300 ft., From _____ ft. to _____ ft.

6 GROUT MATERIAL: 1 Neat cement Cement grout 3 Bentonite 4 Other _____
 Grout Intervals: From Top ft. to 15 ft., From _____ ft. to _____ ft., From _____ ft. to _____ ft.

What is the nearest source of possible contamination:
 1 Septic tank 4 Lateral lines 7 Pit privy 10 Livestock pens 14 Abandoned water well
 2 Sewer lines 5 Cess pool 8 Sewage lagoon 11 Fuel storage 15 Oil well/Gas well
 3 Watertight sewer lines 6 Seepage pit 9 Feedyard 12 Fertilizer storage 16 Other (specify below)
 13 Insecticide storage

Direction from well? West How many feet? 300

FROM	TO	LITHOLOGIC LOG	FROM	TO	LITHOLOGIC LOG
0	20	05 Sand			
20	60	Sand + white clay			
60	100	04 Sand + brown clay			
100	170	13 Fine gravel			
170	200	35 Gravel + brown clay			
200	270	11 Gravel			
270	300	35 Gravel + brown clay			

(used 200# casing from top to 240 80 Sch 240-300)

7 CONTRACTOR'S OR LANDOWNER'S CERTIFICATION: This water well was (1) constructed, (2) reconstructed, or (3) plugged under my jurisdiction and was completed on (mo/day/year) 11-15-83 and this record is true to the best of my knowledge and belief. Kansas Water Well Contractor's License No. A101 This Water Well Record was completed on (mo/day/yr) 11-21-83 under the business name of Bartel Dely by (signature) Rich R Bartel

INSTRUCTIONS: Use typewriter or ball point pen, PLEASE PRESS FIRMLY and PRINT clearly. Please fill in blanks, underline or circle the correct answers. Send top three copies to Kansas Department of Health and Environment, Division of Environment, Environmental Geology Section, Topeka, KS 66620. Send one to WATER WELL OWNER and retain one for your records.

OFFICE USE ONLY T 31 R 34 E 10 SW 1/4 SE 1/4

D