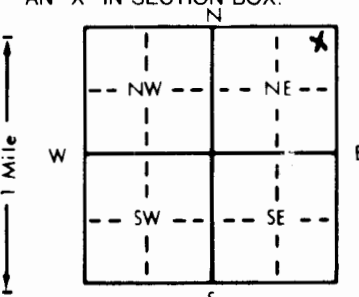


1 LOCATION OF WATER WELL: County: Seward Fraction: NE 1/4 NE 1/4 Section Number: 18 Township Number: T 31 S Range Number: R 34 E/W

Distance and direction from nearest town or city street address of well if located within city?
5 Miles South + 3 West of Atlanta, Ks

2 WATER WELL OWNER: Perry Ross
 RR#, St. Address, Box #: 512 N. Ridgewood Rd. Board of Agriculture, Division of Water Resources
 City, State, ZIP Code: Ulysses, Kansas 67880 Application Number:

3 LOCATE WELL'S LOCATION WITH AN "X" IN SECTION BOX:

 4 DEPTH OF COMPLETED WELL: 288 ft. ELEVATION: slope
 Depth(s) Groundwater Encountered 1. 175 ft. 2. _____ ft. 3. _____ ft.
 WELL'S STATIC WATER LEVEL 175 ft. below land surface measured on mo/day/yr 4/30/91
 Pump test data: Well water was Did not install pump ft. after _____ hours pumping _____ gpm
 Est. Yield _____ gpm: Well water was _____ ft. after _____ hours pumping _____ gpm
 Bore Hole Diameter 9.7/8 in. to 288 ft., and _____ in. to _____ ft.
 WELL WATER TO BE USED AS: 5 Public water supply 8 Air conditioning 11 Injection well
 1 Domestic 3 Feedlot 6 Oil field water supply 9 Dewatering 12 Other (Specify below)
 2 Irrigation 4 Industrial 7 Lawn and garden only 10 Monitoring well
 Was a chemical/bacteriological sample submitted to Department? Yes _____ No X _____ If yes, mo/day/yr sample was submitted
 Water Well Disinfected? Yes X No

5 TYPE OF BLANK CASING USED:
 1 Steel 3 RMP (SR) 5 Wrought iron 8 Concrete tile CASING JOINTS: Glued X Clamped _____
 2 PVC 4 ABS 6 Asbestos-Cement 9 Other (specify below) Welded & riveted
 7 Fiberglass Threaded _____
 Blank casing diameter _____ in. to 248 ft., Dia _____ in. to _____ ft., Dia _____ in. to _____ ft.
 Casing height above land surface: 18 in., weight schedule 200 lbs./ft. Wall thickness or gauge No. _____
 TYPE OF SCREEN OR PERFORATION MATERIAL:
 1 Steel 3 Stainless steel 5 Fiberglass 7 PVC 10 Asbestos-cement
 2 Brass 4 Galvanized steel 6 Concrete tile 9 ABS 11 Other (specify) _____
 12 None used (open hole)
 SCREEN OR PERFORATION OPENINGS ARE:
 1 Continuous slot 3 Mill slot 5 Gauzed wrapped 8 Saw cut 11 None (open hole)
 2 Louvered shutter 4 Key punched 6 Wire wrapped 9 Drilled holes
 7 Torch cut 10 Other (specify) _____
 SCREEN-PERFORATED INTERVALS: From 248 ft. to 288 ft., From _____ ft. to _____ ft.
 GRAVEL PACK INTERVALS: From 150 ft. to 288 ft., From _____ ft. to _____ ft.
 From 24 ft. to 288 ft., From _____ ft. to _____ ft.

6 GROUT MATERIAL: 1 Neat cement 2 Cement grout 3 Bentonite 4 Other _____
 Grout Intervals: From 4 ft. to 24 ft., From 24 ft. to 150 ft., From _____ ft. to _____ ft.
 What is the nearest source of possible contamination:
 1 Septic tank 4 Lateral lines 7 Pit privy 10 Livestock pens 14 Abandoned water well
 2 Sewer lines 5 Cess pool 8 Sewage lagoon 11 Fuel storage 15 Oil well/Gas well
 3 Watertight sewer lines 6 Seepage pit 9 Feedyard 12 Fertilizer storage 16 Other (specify below)
 13 Insecticide storage _____ field
 Direction from well? _____ How many feet? _____

FROM	TO	LITHOLOGIC LOG	FROM	TO	PLUGGING INTERVALS
0	2	Surface			
2	15	Clay with fine sand			
15	85	Coarse sand w/some gravel			
85	95	Cemented sand			
95	297	Coarse sand and gravel			
297	300	White chalky clay			

7 CONTRACTOR'S OR LANDOWNER'S CERTIFICATION: This water well was (1) constructed, (2) reconstructed, or (3) plugged under my jurisdiction and was completed on (mo/day/year) April 30, 1991 and this record is true to the best of my knowledge and belief. Kansas Water Well Contractor's License No. 164 This Water Well Record was completed on (mo/day/yr) May 17, 1991 under the business name of Houck Bros. Drilling Co. by (signature) M. Beard

OFFICE USE ONLY
T
R
EW
SEC.
1/4
1/4
1/4