


1 LOCATION OF WATER WELL: County: **SEWARD** Fraction: **NW 1/4 NW 1/4 SW 1/4** Section Number: **23** Township Number: **T 31 S** Range Number: **R 34** **SW**

Distance and direction from nearest town or city street address of well if located within city?  
**6 1/2 South and 1 West of Satanta, Kansas**

2 WATER WELL OWNER: **Mr. Jack Conover**  
 RR#, St. Address, Box #: **Box 607**  
 City, State, ZIP Code: **Satanta, Kansas 67870**  
 Board of Agriculture, Division of Water Resources  
 Application Number: **---**

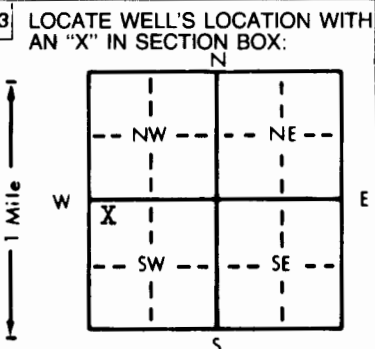

4 DEPTH OF COMPLETED WELL: **290** ft. ELEVATION: **Slope**  
 Depth(s) Groundwater Encountered: **1. Not available** ft. 2. **---** ft. 3. **---** ft.  
 WELL'S STATIC WATER LEVEL: **210** ft. below land surface measured on mo/day/yr **March 19, 1990**  
 Pump test data: Well water was **---** ft. after **---** hours pumping **---** gpm  
 Est. Yield: **20** gpm. Well water was **---** ft. after **---** hours pumping **---** gpm  
 Bore Hole Diameter: **10** in. to **290** ft., and **---** in. to **---** ft.  
 WELL WATER TO BE USED AS:  
 5 Public water supply  8 Air conditioning  11 Injection well  
 2 Domestic  3 Feedlot  6 Oil field water supply  9 Dewatering  12 Other (Specify below)  
 2 Irrigation  4 Industrial  7 Lawn and garden only  10 Monitoring well  
 Was a chemical/bacteriological sample submitted to Department? Yes **---** No **XX**; If yes, mo/day/yr sample was submitted **---**  
 Water Well Disinfected? Yes **XX** No **---**

5 TYPE OF CASING USED:  
 1 Steel  3 RMP (SR)  6 Asbestos-Cement  9 Other (specify below)  
 2 PVC  4 ABS  7 Fiberglass  8 Concrete tile  10 Asbestos-cement  
 CASING JOINTS: Glued **XX** Clamped **---**  
 Welded **---**  
 Threaded **---**

Blank casing diameter: **5** in. to **270** ft., Dia. **---** in. to **---** ft., Dia. **---** in. to **---** ft.  
 Casing height above land surface: **18** in., weight **3.92** lbs./ft. Wall thickness or gauge No. **375**

TYPE OF SCREEN OR PERFORATION MATERIAL:  
 1 Steel  3 Stainless steel  5 Fiberglass  8 RMP (SR)  11 Other (specify)  
 2 Brass  4 Galvanized steel  6 Concrete tile  9 ABS  12 None used (open hole)

SCREEN OR PERFORATION OPENINGS ARE:  
 1 Continuous slot  3 Mill slot  5 Gauzed wrapped  6 Saw cut  11 None (open hole)  
 2 Louvered shutter  4 Key punched  6 Wire wrapped  9 Drilled holes  
 7 Torch cut  10 Other (specify)

SCREEN-PERFORATED INTERVALS: From **270** ft. to **290** ft., From **---** ft. to **---** ft., From **---** ft. to **---** ft.  
 GRAVEL PACK INTERVALS: From **30** ft. to **290** ft., From **---** ft. to **---** ft., From **---** ft. to **---** ft.

6 GROUT MATERIAL:  1 Neat cement  2 Cement grout  3 Bentonite  4 Other **Baroid Hole Plug**  
 Grout Intervals: From **0** ft. to **30** ft., From **---** ft. to **---** ft., From **---** ft. to **---** ft.

What is the nearest source of possible contamination: **NONE**  
 1 Septic tank  4 Lateral lines  7 Pit privy  10 Livestock pens  14 Abandoned water well  
 2 Sewer lines  5 Cess pool  8 Sewage lagoon  11 Fuel storage  15 Oil well/Gas well  
 3 Watertight sewer lines  6 Seepage pit  9 Feedyard  12 Fertilizer storage  16 Other (specify below)  
 13 Insecticide storage

Direction from well?			How many feet?		
FROM	TO	LITHOLOGIC LOG	FROM	TO	PLUGGING INTERVALS
0	7	Clay			
7	10	Fine Sand			
10	71	Clay			
71	290	Med. Gravel			
290	--	Clay			

7 CONTRACTOR'S OR LANDOWNER'S CERTIFICATION: This water well was (1) constructed, (2) reconstructed, or (3) plugged under my jurisdiction and was completed on (mo/day/year) **March 21, 1990** and this record is true to the best of my knowledge and belief. Kansas Water Well Contractor's License No. **252**. This Water Well Record was completed on (mo/day/yr) **March 21, 1990** under the business name of **Friesen Windmill & Supply Inc.** by (signature) **[Signature]**

OFFICE USE ONLY  
T  
R  
EW  
SEC.  
1/4  
1/4

**910802068-13**