USE TYPEWRITER OR BALL POINT PEN-PRESS FIRMLY, PRINT CLEARLY.

WATER WELL RECORD
KSA 82a-1201-1215

Kansas Department of Health and Environment-Division of Environment
(Water well Contractors)
Topeka, Kansas 66620

1. Location of well:	County	Fraction	Section number	Township number	Range number
	Seward	~~SW~~ SE 1/4 ~~SW~~ SE 1/4 NW 1/4	25	T 31 S	R 34 E W

2. Distance and direction from nearest town or city: 5 south, 1 east, 3 south, 3/4 west, ½ south of Satanta
Street address of well location if in city:

3. Owner of well: Chuck Conover
R.R. or street: RR
City, state, zip code: Satanta, Kansas 67870

4. Locate with "X" in section below: Sketch map:

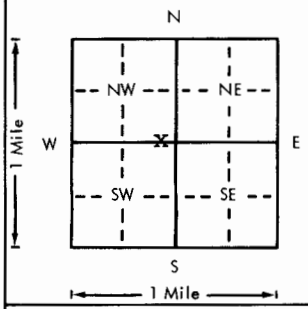

6. Bore hole dia. 9 7/8" in. Completion date
Well depth 306 ft. 6-01-77

7. __ Cable tool X Rotary __ Driven __ Dug
__ Hollow rod __ Jetted __ Bored __ Reverse rotary

8. Use: __ Domestic __ Public supply __ Industry
__ Irrigation __ Air conditioning X Stock
__ Lawn __ Oil field water __ Other

9. Casing: Material ~~XXX~~ Styrene Height: Above or ~~below~~
Threaded __ Welded X Surface 12 in.
RMP __ PVC __ Weight 2.8 lbs./ft.
Dia. 5 in. to 306 ft. depth Wall Thickness: inches or
Dia. __ in. to __ ft. depth gage No. .265

5. Type and color of material	From	To
Top soil	0	5
Sandy clay	5	65
Gravel (clay streaks)	65	88
Gravel (Large Rock)	88	125
Med. to lar. sand & gravel (small clay streaks)	125	310

10. Screen: Manufacturer's name Jess & Lowell
Type Styrene Dia. 5"
Slot/~~gauze~~ 1/8" Length 70'
Set between 196 ft. and 306 ft.
ft. and ft.
Gravel pack? Yes Size range of material #1 fine

11. Static water level: mo./day/yr.
177 ft. below land surface Date 5/27/77

12. Pumping level below land surfaces:
161 ft. after 1 hrs. pumping 25 g.p.m.
ft. after hrs. pumping g.p.m.
Estimated maximum yield g.p.m.

13. Water sample submitted: mo./day/yr.
__ Yes XX No Date

14. Well head completion:
__ Pitless adapter 12 Inches above grade

15. Well grouted? Yes
With: __ Neat cement __ Bentonite X Concrete
Depth: From 0 ft. to 10 ft.

16. Nearest source of possible contamination:
ft. 30 Direction SW Type old well
Well disinfected upon completion? XX Yes __ No

17. Pump: __ Not installed
Manufacturer's name Transferred Customers
Model number Windmill HP Volts
Length of ~~drop~~ pipe 208 ft. capacity 3 g.p.m.
Type:
__ Submersible __ Turbine
__ Jet __ Reciprocating
__ Centrifugal X Other

(Use a second sheet if needed)

18. Elevation:

Topography:
__ Hill
__ Slope
XX Upland
__ Valley

19. Remarks:
Well abandoned & plugged, MNC.

20. Water well contractor's certification:
This well was drilled under my jurisdiction and this report is true to the best of my knowledge and belief.
Friesen Windmill 252
Business name License No.
Address Meade, Kansas 67864
Signed Authorized representative Date 6-22-77

T 31 R 34 E W Sec 25 1/4 SE 1/4 SE 1/4 NW

Forward the white, blue and pink copies to the Department of Health and Environment

Form WWC-5

MI-1023