USE TYPEWRITER OR BALL POINT PEN-PRESS FIRMLY, PRINT CLEARLY.

WATER WELL RECORD
KSA 82a-1201-1215

Kansas Department of Health and Environment-Division of Environment
(Water well Contractors)
Topeka, Kansas 66620

1. Location of well:	County	Fraction	Section number	Township number	Range number
	Seward	SE 1/4 SW/4 SE 1/4	33	T 31 S	R 34 E/W

2. Distance and direction from nearest town or city: 4 south, 4 east, 7 south, 7 west, 2 north & ½ east of Satanta
Street address of well location if in city:

3. Owner of well: Clinton Stalker
R.R. or street: RFD
City, state, zip code: Satanta, Kansas 67870

4. Locate with "X" in section below:

Sketch map:

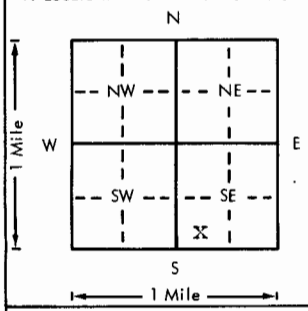

6. Bore hole dia. 9 7/8 in. Completion date _____
Well depth 228 ft. 7-14-77

7. __ Cable tool X Rotary __ Driven __ Dug
__ Hollow rod __ Jetted __ Bored __ Reverse rotary

8. Use: X Domestic __ Public supply __ Industry
__ Irrigation __ Air conditioning __ Stock
__ Lawn __ Oil field water __ Other

9. Casing: Material PVC
Threaded ___ Welded XX
RMP ___ PVC X
Dia. 5 in. to 228 ft. depth
Dia. ___ in. to ___ ft. depth
Height: Above or ~~below~~ Surface 12 in.
Weight 2.8 lbs./ft.
Wall Thickness: inches or gage No. .265

5. Type and color of material	From	To
Top soil	0	7
Clay	7	22
Med. to lar. sand	22	95
Fine sand (to med.)	95	135
Fine sand & med. to lar. sand	135	228
Blue clay	228	230

(Use a second sheet if needed)

10. Screen: Manufacturer's name Jess & Lowell
Type PVC Dia. ___
Slot/~~gauge~~ 1/8" Length 50'
Set between 228 ft. and 148 ft.
___ ft. and ___ ft.
Gravel pack? Yes Size range of material 1/64-5/32

11. Static water level: mo./day/yr.
69 ft. below land surface Date 7/8/77

12. Pumping level below land surfaces:
___ ft. after ___ hrs. pumping ___ g.p.m.
___ ft. after ___ hrs. pumping ___ g.p.m.
Estimated maximum yield ___ g.p.m.

13. Water sample submitted: mo./day/yr.
___ Yes X No Date ___

14. Well head completion:
___ Pitless adapter 24" Inches above grade

15. Well grouted? Yes
With: XX Neat cement ___ Bentonite ___ Concrete
Depth: From 10 ft. to 0 ft.

16. Nearest source of possible contamination: NONE
ft. ___ Direction ___ Type ___
Well disinfected upon completion? XX Yes ___ No

17. Pump: Transferred ___ Not installed
Manufacturer's name Customers Windmill
Model number ___ HP ___ Volts ___
Length of drop pipe 108 ft. capacity 3 g.p.m.
Type:
___ Submersible ___ Turbine
___ Jet ___ Reciprocating
___ Centrifugal XX Other

18. Elevation:

Topography:
___ Hill
___ Slope
___ Upland
XX Valley

19. Remarks:

20. Water well contractor's certification:
This well was drilled under my jurisdiction and this report is true to the best of my knowledge and belief.
Friesen Windmill 252
Business name License No.
Address Meade, Kansas 67864
Signed [signature] Date 8-26-77
Authorized representative

T 31 R 34 E/W Sec 33 1/4 SE 1/4 SE 1/4

Forward the white, blue and pink copies to the Department of Health and Environment

Form WWC-5

MI-1023