

WATER WELL RECORD Form #WC-5 KSA 87a-1212

1 LOCATION OF WATER WELL: Fraction Section Number Township Number Range Number
 COUNTY: 088 SEWARD NW 1/4 NW 1/4 NW 1/4 12 T 31 S R 34 W

Distance and direction from nearest town or city street address of well if located within city?

APPROX. 1/2 MILE EAST & 4 MILES SOUTH OF SATANTA

2 WATER WELL OWNER: RON OLIVER %FRIESEN WIND.


RR#, St. Address, Box # : 215 N. POST

City, State, ZIP code : MEADE, KS 67864-

Board of Agriculture, Division of Water Resources

Application Number:

3 LOCATE WELL'S LOCATION WITH AN "X" IN SECTION BOX:

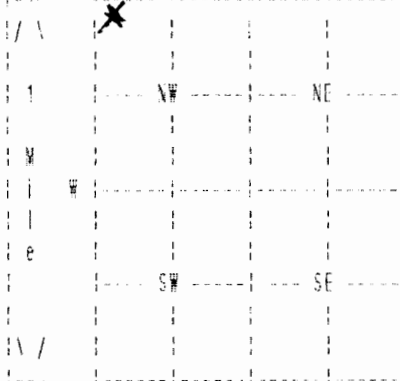

4 DEPTH OF COMPLETED WELL 459 ELEVATION: 0
 Depth(s) Groundwater Encountered 1. 0 ft. 2. 0 ft. 3. 0 ft.

WELL'S STATIC WATER LEVEL 240 ft. below land surface measured on mo/day/yr 05/09/95
 Pump testdata: Well water was 0 ft. after 0 hours pumping 0 gpm

Estimated Yield 0 gpm: Well water was 0 ft. after 0 hours pumping 0 gpm

Bore Hole Diameter 24 in. to 459 ft., and in. to 0 ft.

WELL WATER TO BE USED AS: 01 DOMESTIC

Was a chemical/bacteriological sample submitted to department? No ;
 If yes, mo/day/yr sample was submitted Water well disinfected? Yes

5 TYPE OF BLANK CASING USED: 02 PVC CASING JOINTS: GLUED

Blank casing diameter 5 in. to 459 ft., Dia in. to 0 ft., Dia in. to 0 ft.
 Casing height above land surface 12 in., weight 3 lbs/ft. Wall thickness or gauge No. .265

TYPE OF SCREEN OR PERFORATION MATERIAL: 07 PVC
 SCREEN OR PERFORATION OPENINGS ARE: 03 MILL SLOT

SCREEN PERFORATED INTERVALS: From 399 ft. to 459 ft., From 0 ft. to 0 ft.
 From 0 ft. to 0 ft., From 0 ft. to 0 ft.
 GRAVEL PACK INTERVALS: From 25 ft. to 459 ft., From 0 ft. to 0 ft.
 From 0 ft. to 0 ft., From 0 ft. to 0 ft.

6 GROUT MATERIAL 03 BENTONITE

Grout Intervals: From 5 ft. to 25 ft., From 0 ft. to 0 ft., From 0 ft. to 0 ft.

What is the nearest source of possible contamination: 14 ABAND. WELL

Direction from well? NE How many feet? 49

FROM	TO	LITHOLOGIC LOG	FROM	TO	PLUGGING INTERVALS
0	1	02 SILT			
1	12	01 CLAY			
12	47	04 SANDY CLAY 31 CALICHE			
47	60	07 FINE SAND 04 SANDY CLAY			
60	75	04 SANDY CLAY 31 CALICHE 05 SAND			
75	100	01 CLAY 31 CALICHE			
100	105	05 SAND 13 FINE GRAVEL			
105	115	01 CLAY 31 CALICHE			
115	217	05 SAND 13 FINE GRAVEL			
217	235	07 FINE SAND 04 SANDY CLAY 31 CALICHE			

7 CONTRACTOR'S OR LANDOWNER'S CERTIFICATION: This water well was Constructed under my jurisdiction and was completed on (mo/day/year) 05/09/95 and this record is true to the best of my knowledge and belief. Kansas Water Well Contractor's License No. 145 This Water Well Record was completed on (mo/day/yr) 05/18/95 under the business name of HENKLE DRILLING & SUPPLY by (signature)

