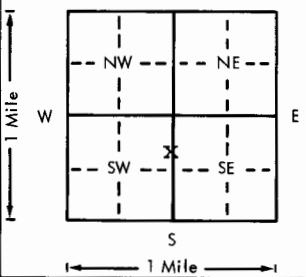


USE TYPEWRITER OR BALL
POINT PEN-PRESS FIRMLY,
PRINT CLEARLY.

WATER WELL RECORD
KSA 82a-1201-1215

Kansas Department of Health and
Environment-Division of Environment
(Water well Contractors)
Topeka, Kansas 66620

1. Location of well:		County Stevens	Fraction SE 1/4 NE 1/4 SW 1/4	Section number 19	Township number T 31S	Range number S R 35W	EW
2. Distance and direction from nearest town or city: From Moscow go 2 Miles East and 1/2 mile North Street address of well location if in city:			3. Owner of well: Mrs. Helen Bunton R.R. or street: 1100 So. Main City, state, zip code: Hugoton, Kansas 67951				
4. Locate with "X" in section below:		Sketch map:			6. Bore hole dia. 28 in. Completion date _____ Well depth 497 ft. 12-30-77		
		949' South of NE Corner of the SW 1/4, Sec. 19, T31S, R35W, Stevens County, Kansas			7. <input type="checkbox"/> Cable tool <input type="checkbox"/> Rotary <input type="checkbox"/> Driven <input type="checkbox"/> Dug <input type="checkbox"/> Hollow rod <input type="checkbox"/> Jetted <input type="checkbox"/> Bored <input checked="" type="checkbox"/> Reverse rotary		
5. Type and color of material					8. Use: <input type="checkbox"/> Domestic <input type="checkbox"/> Public supply <input type="checkbox"/> Industry <input checked="" type="checkbox"/> Irrigation <input type="checkbox"/> Air conditioning <input type="checkbox"/> Stock <input type="checkbox"/> Lawn <input type="checkbox"/> Oil field water <input type="checkbox"/> Other		
					9. Casing: Material Steel Height: Above or below Threaded <input type="checkbox"/> Welded <input checked="" type="checkbox"/> Surface 12 in. RMP <input type="checkbox"/> PVC <input type="checkbox"/> Weight 37 lbs./ft. Dia. 16 in. to 212 ft. depth Wall Thickness: inches or Dia. _____ in. to _____ ft. depth gage No. .219		
					10. Screen: Manufacturer's name Doerr, Foster Louwer Type Millslot Dia. 16 Slot/gauze 1/8 Length 285 Set between 212 ft. and 497 ft. Gravel pack? Yes Size range of material 2.9mm		
					11. Static water level: _____ mo./day/yr. 250 ft. below land surface Date 11-23-77		
					12. Pumping level below land surfaces: 352 ft. after 1 hrs. pumping 530 g.p.m. 418 ft. after 1 1/2 hrs. pumping 604 g.p.m. Estimated maximum yield 600 g.p.m.		
					13. Water sample submitted: _____ mo./day/yr. <input type="checkbox"/> Yes <input checked="" type="checkbox"/> No Date _____		
					14. Well head completion: <input type="checkbox"/> Pitless adapter 12 inches above grade		
					15. Well grouted? Yes With: <input type="checkbox"/> Neat cement <input checked="" type="checkbox"/> Bentonite <input type="checkbox"/> Concrete Depth: From 0 ft. to 10 ft.		
					16. Nearest source of possible contamination: ft. _____ Direction _____ Type Unknown Well disinfected upon completion? <input checked="" type="checkbox"/> Yes <input type="checkbox"/> No		
					17. Pump: _____ Not installed Manufacturer's name Layne & Bowler Model number 11 BH HP 100 Volts _____ Length of drop pipe 470 ft. capacity 600 g.p.m. Type: <input type="checkbox"/> Submersible <input checked="" type="checkbox"/> Turbine <input type="checkbox"/> Jet <input type="checkbox"/> Reciprocating <input type="checkbox"/> Centrifugal <input type="checkbox"/> Other		
18. Elevation:		19. Remarks:			20. Water well contractor's certification: This well was drilled under my jurisdiction and this report is true to the best of my knowledge and belief. Layne-Western Co., Inc. 102 Business name _____ License No. _____ Address Box 686, Garden City, Ks. Signed R. J. Vincent Date 6 Feb 78 Authorized representative		
Topography: <input type="checkbox"/> Hill <input type="checkbox"/> Slope <input checked="" type="checkbox"/> Upland <input type="checkbox"/> Valley							

31
35W
19
SE NE SW
1/4 1/4 1/4