


USE TYPEWRITER OR BALL POINT PEN-PRESS FIRMLY, PRINT CLEARLY.

WATER WELL RECORD
KSA 82a-1201-1215

Kansas Department of Health and Environment-Division of Environment (Water well Contractors) Topeka, Kansas 66620

1. Location of well: County Stevens Fraction NW 1/4 NW 1/4 SE 1/4 Section number 36 Township number T 31 S Range number R 35 E/W

2. Distance and direction from nearest town or city: 7 EAST + 1 SOUTH OF MOSCOW, KAN
Street address of well location if in city:
3. Owner of well: Sam Clift
R.R. or street: 1105 GRETCHEN LANE
City, state, zip code: WHITMAN, KAN 17206

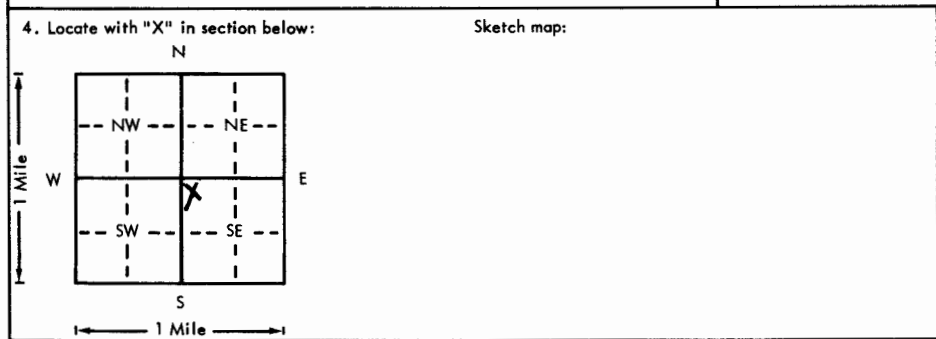

6. Bore hole dia. 26 in. Completion date 9/29/76
Well depth 604 ft.
7. Cable tool Rotary Driven Dug
 Hollow rod Jetted Bored Reverse rotary
8. Use: Domestic Public supply Industry
 Irrigation Air conditioning Stock
 Lawn Oil field water Other
9. Casing: Material Steel Height: Above or below
Threaded Welded Surface 12 in.
RMP PVC Weight 42.5 lbs./ft.
Dia. 16 in. to 604 ft. depth Wall Thickness: inches or
Dia. in. to ft. depth gage No. 250

5. Type and color of material	From	To
Surface & Overburden	0	288
Top Soil	2	220
Med. Sd. w/Clay Strks.	220	440
White & Brn. Clay w/Sd. Strks.	440	460
Brn. Clay w/Firm Sd. Strks.	460	480
Firm Yellow Sd. Stone	480	520
Firm Fine Sd. w/Rock Strks.	520	600
Firm Fine Sd. & Red Bed	600	632
(Use a second sheet if needed)		

10. Screen: Manufacturer's name L. B. Foster
Type Steel Dia. 16"
Slot/gauze 1/8 Length 3
Set between 440-256 ft. and 420-400 ft.
420 ft. and 604 ft.
Gravel pack? Size range of material 1/8-1/4
11. Static water level: 243 ft. below land surface Date 9/30/76 mo./day/yr.
12. Pumping level below land surfaces: N/A
 ft. after hrs. pumping g.p.m.
 ft. after hrs. pumping g.p.m.
Estimated maximum yield g.p.m.
13. Water sample submitted: mo./day/yr.
Yes No Date
14. Well head completion:
 Pitless adapter 1 1/4 inches above grade
15. Well grouted? yes
With: 10 Neat cement Bentonite Concrete
Depth: From 0 ft. to 10 ft.
16. Nearest source of possible contamination: ft. Direction Field SW AC Type
Well disinfected upon completion? Yes No
17. Pump: Not installed
Manufacturer's name
Model number HP Volts
Length of drop pipe ft. capacity g.p.m.
Type:
 Submersible Turbine
 Jet Reciprocating
 Centrifugal Other

18. Elevation:
Topography:
 Hill
 Slope
 Upland
 Valley
19. Remarks: 10a Johnson Irr
16" Steel
1000 slot
400-420'
10a. Crop Land

20. Water well contractor's certification:
This well was drilled under my jurisdiction and this report is true to the best of my knowledge and belief.
KTM DRILLING, INC. 225
Business name Box 385 Guymon, OK 1a. License No.
Address
Signed Date 11/1/76
Authorized representative

31 350 36 NW 1/4 SE