

CORRECTION(S) TO WATER WELL RECORD (WWC-5)  
(to rectify lacking or incorrect information)

County: Stevens

Location listed as:

Location changed to:

Section-Township-Range: 28-315-35

28-315-35W

Fraction ( 1/4 1/4 1/4): None Given

SW SE SE SW

Other changes: Initial statements: \_\_\_\_\_

Changed to: \_\_\_\_\_

Comments: \_\_\_\_\_

verification method: Latitude & longitude, KGS' "LEO" conversion tool,  
and mapping tool on KGS website.

initials: DRK date: 3/15/2012

submitted by: Kansas Geological Survey, Data Resources Library, 1930 Constant Ave., Lawrence, KS 66047-3726  
to: Kansas Dept of Health & Environment, Bureau of Water, 1000 SW Jackson, Suite 420, Topeka, KS 66612-1367.

**WATER WELL PLUGGING RECORD Form WWC-5P**

KSA 82a-1212

ID NO.


10,109

<b>1 LOCATION OF WATER WELL:</b> County: <b>STEVENS</b>	Fraction ¼ ¼ ¼ ¼	Section Number <b>28</b>	Township Number T <b>31</b> S	Range Number <b>35</b> <input type="checkbox"/> E <input type="checkbox"/> W
--	---------------------	-----------------------------	----------------------------------	---

Street/Rural Address of Well Location; if unknown, distance & direction from nearest town or intersection: If at owner's address, check here  From Cave 3 miles south on Rd. 24, then approx. 1/2 mile east on road Y on the north side

**2 WATER WELL OWNER:** Milton Gillespie  
RR#, St. Address, Box #: 2030 State Hwy 25  
City, State ZIP Code: Hugoton Ks. 67951

**Global Positioning Systems (GPS) information:**  
Latitude: N37.31530 (in decimal degrees)  
Longitude: W101.13306 (in decimal degrees)  
Elevation: 3011'  
Datum:  WGS84,  NAD83,  NAD27  
Collection Method:  
 GPS unit (Make/Model: Magellon Triton)  
 Digital Map/Photo,  Topographic Map,  Land Survey  
Est. Accuracy:  < 3 m,  3-5 m,  5-15 m,  > 15 m

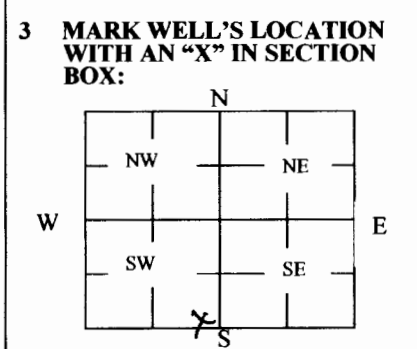

**4 DEPTH OF WELL** 523' ft.  
WELL'S STATIC WATER LEVEL 345' ft.  
WELL WAS USED AS:  
 Domestic  Public Water Supply  Dewatering  
 Irrigation  Oil Field Water Supply  Monitoring  
 Feedlot  Domestic (Lawn & Garden)  Injection Well  
 Industrial  Air Conditioning  Other \_\_\_\_\_  
Was a chemical/bacteriological sample submitted to Department? Yes  No

**5 TYPE OF BLANK CASING USED:**  
 Steel  RMP (SR)  Wrought  Fiberglass  Other (Specify below)  
 PVC  ABS  Asbestos-Cement  Concrete Tile  
Blank casing diameter 16 in. Was casing pulled? Yes  No  If yes, how much 72"  
Casing height above or below land surface below 72 in.

**6 GROUT PLUG MATERIAL:**  Neat cement  Cement grout  Bentonite  Other \_\_\_\_\_  
Grout Plug Intervals: From 6 ft. to 16 ft., From \_\_\_\_\_ ft. to \_\_\_\_\_ ft., From \_\_\_\_\_ to \_\_\_\_\_ ft.  
What is the nearest source of possible contamination:  
 Septic tank  Seepage pit  Fuel Storage  Other (specify below)  
 Sewer lines  Pit privy  Fertilizer storage  None Observed  
 Watertight sewer lines  Sewage lagoon  Insecticide storage  
 Lateral lines  Feedyard  Abandoned water well Direction from well? \_\_\_\_\_  
 Cess pool  Livestock pens  Oil well/Gas well How many feet? \_\_\_\_\_

FROM	TO	PLUGGING MATERIALS	FROM	TO	PLUGGING MATERIALS
523'	16'	Chlorinated Road Sand	16'	6'	3,000 PSI Concrete
6'	0'	Dug down, cut off casing, backfill			

**7 CONTRACTOR'S OR LANDOWNER'S CERTIFICATION:** This water well was plugged under my jurisdiction and was completed on (mo/day/year) 8/4/2011 and this record is true to the best of my knowledge and belief. Kansas Water Well Contractor's License No. 145. This Water Well Record was completed on (mo/day/year) 8/4/2011 under the business name of Hydro Resources Mid Continent by (signature) Gary Clepper

**INSTRUCTIONS:** Use typewriter or ballpoint pen. Please press firmly and print clearly. Please fill in blanks, underline or circle the correct answers. Send top three copies to Kansas Department of Health and Environment, Bureau of Water, Geology Section, 1000 SW Jackson St., Ste. 420, Topeka, Kansas 66612-1367. Telephone: 785/296-5524. Send one to Water Well Owner and retain one for your records. Visit us at <http://www.kdheks.gov/waterwell/index.html>.

Check one:  White Copy  Blue Copy  Pink Copy