

# WATER WELL PLUGGING RECORD Form WWC-5P KSA 82a-1212 ID NO.

1 LOCATION OF WATER WELL: Fraction SW 1/4 SW 1/4 NW 1/4 SE 1/4 Section Number 9 Township Number T 31 S Range Number 35 ☐ E ☒ W


Street/Rural Address of Well Location; if unknown, distance & direction from nearest town or intersection: If at owner's address, check here ☐ Intersection of Roads 24 & BB  
1/2 mile east - 1/4 mile North

Global Positioning Systems (GPS) information:  
Latitude: \_\_\_\_\_ (in decimal degrees)  
Longitude: \_\_\_\_\_ (in decimal degrees)  
Elevation: \_\_\_\_\_  
Datum: ☐ WGS84, ☐ NAD83, ☐ NAD27  
Collection Method: \_\_\_\_\_

2 WATER WELL OWNER: James Cullison  
RR#, St. Address, Box #: Box 367  
City, State ZIP Code: St. Mary, KS 67870

☐ GPS unit (Make/Model: \_\_\_\_\_)  
☐ Digital Map/Photo, ☐ Topographic Map, ☐ Land Survey  
Est. Accuracy: ☐ < 3 m, ☐ 3-5 m, ☐ 5-15 m, ☐ > 15 m

3 MARK WELL'S LOCATION WITH AN "X" IN SECTION BOX:

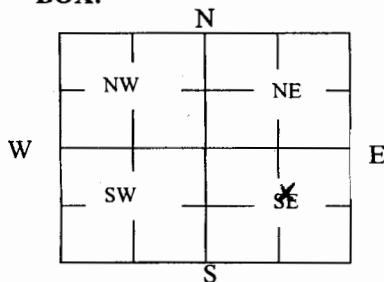

4 DEPTH OF WELL 397 ft.

WELL'S STATIC WATER LEVEL 330 ft

WELL WAS USED AS:

☒ Domestic ☐ Public Water Supply ☐ Dewatering  
☒ Irrigation ☐ Oil Field Water Supply ☐ Monitoring  
☐ Feedlot ☐ Domestic (Lawn & Garden) ☐ Injection Well  
☐ Industrial ☐ Air Conditioning ☐ Other \_\_\_\_\_

Was a chemical/bacteriological sample submitted to Department? Yes ☐ No ☒

5 TYPE OF BLANK CASING USED:

☒ Steel ☐ RMP (SR) ☐ Wrought ☐ Fiberglass ☐ Other (Specify below)  
☐ PVC ☐ ABS ☐ Asbestos-Cement ☐ Concrete Tile

Blank casing diameter 16 in. Was casing pulled? Yes ☐ No ☒ If yes, how much \_\_\_\_\_  
Casing height above or below land surface 72 in.

6 GROUT PLUG MATERIAL: ☒ Neat cement ☐ Cement grout ☒ Bentonite ☐ Other \_\_\_\_\_

Grout Plug Intervals: From 6 ft. to 19 ft., From 274 ft. to 280 ft., From \_\_\_\_\_ ft. to \_\_\_\_\_ ft.

What is the nearest source of possible contamination:

☐ Septic tank ☐ Seepage pit ☐ Fuel storage ☐ Other (specify below) \_\_\_\_\_  
☐ Sewer lines ☐ Pit privy ☐ Fertilizer storage ☐ \_\_\_\_\_  
☐ Watertight sewer lines ☐ Sewage lagoon ☐ Insecticide storage ☐ \_\_\_\_\_  
☐ Lateral lines ☐ Feedyard ☐ Abandoned water well Direction from well? \_\_\_\_\_  
☐ Cess pool ☐ Livestock pens ☐ Oil well/Gas well How many feet? \_\_\_\_\_

FROM	TO	PLUGGING MATERIALS	FROM	TO	PLUGGING MATERIALS
<u>397</u>	<u>280</u>	<u>Gravel Fill</u>			
<u>280</u>	<u>274</u>	<u>Hydrated Bentonite Plug</u>			
<u>274</u>	<u>19</u>	<u>Compacted Fill</u>			
<u>19</u>	<u>6</u>	<u>Cement Plug</u>			

7 CONTRACTOR'S OR LANDOWNER'S CERTIFICATION: This water well was plugged under my jurisdiction and was completed on (mo/day/year) 3-18-19 and this record is true to the best of my knowledge and belief. Kansas Water Well Contractor's License No. 805. This Water Well Record was completed on (mo/day/year) 3-21-19 under the business name of Hoskinson Saks & Service by (signature) Richard Hoskinson

INSTRUCTIONS: Use typewriter or ballpoint pen. Please press firmly and print clearly. Please fill in blanks, underline or circle the correct answers. Send top three copies to Kansas Department of Health and Environment, Bureau of Water, Geology Section, 1000 SW Jackson St., Ste. 420, Topeka, Kansas 66612-1367. Telephone: 785/296-5524. Send one to Water Well Owner and retain one for your records. Visit us at <http://www.kdheks.gov/waterwell/index.html>.