


1 LOCATION OF WATER WELL:	Fraction	Section Number	Township Number	Range Number
County: Stevens	NE 1/4 SE 1/4 NE 1/4	3	T 31 S	R 35 EW

Distance and direction from nearest town or city street address of well if located within city? Moscow, Kansas - 5 Miles north- 5 3/4 mi. east - south into location.

2 WATER WELL OWNER: Jim Cullison Mobil Oil Corp./ Unit #19
 RR#, St. Address, Box # : Rt. 1 Board of Agriculture, Division of Water Resources
 City, State, ZIP Code : Moscow, KS. 67952 Application Number: T88-305

3 LOCATE WELL'S LOCATION WITH AN "X" IN SECTION BOX: 4 DEPTH OF COMPLETED WELL: 380 ft. ELEVATION:

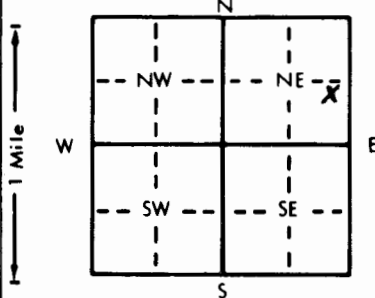

Depth(s) Groundwater Encountered 1. 254 ft. 2. ft. 3. ft.
 WELL'S STATIC WATER LEVEL 254 ft. below land surface measured on mo/day/yr 6-28-88
 Pump test data: Well water was ft. after hours pumping gpm
 Est. Yield 100 gpm: Well water was ft. after hours pumping gpm
 Bore Hole Diameter 11 in. to 380 ft., and in. to ft.
 WELL WATER TO BE USED AS:
 1 Domestic 3 Feedlot 6 Oil field water supply 8 Air conditioning 11 Injection well
 2 Irrigation 4 Industrial 7 Lawn and garden only 9 Dewatering 12 Other (Specify below)
 Was a chemical/bacteriological sample submitted to Department? Yes No X: If yes, mo/day/yr sample was submitted
 Water Well Disinfected? Yes X No

5 TYPE OF BLANK CASING USED:
 1 Steel 3 RMP (SR) 5 Wrought iron 8 Concrete tile CASING JOINTS: Glued X Clamped
 2 PVC 4 ABS 6 Asbestos-Cement 9 Other (specify below) Welded
 7 Fiberglass Threaded

Blank casing diameter 6.625 in. to 260 ft., Dia in. to ft.
 Casing height above land surface -60 in., weight 3.71 lbs./ft. Wall thickness or gauge No. 280

TYPE OF SCREEN OR PERFORATION MATERIAL:
 1 Steel 3 Stainless steel 5 Fiberglass 7 RMP (SR) 10 Asbestos-cement
 2 Brass 4 Galvanized steel 6 Concrete tile 9 ABS 12 None used (open hole)

SCREEN OR PERFORATION OPENINGS ARE:
 1 Continuous slot 3 Mill slot 5 Gauzed wrapped 8 Saw cut 11 None (open hole)
 2 Louvered shutter 4 Key punched 7 Torch cut 9 Drilled holes 10 Other (specify)

SCREEN-PERFORATED INTERVALS: From 260 ft. to 380 ft., From ft. to ft.
 GRAVEL PACK INTERVALS: From 22 ft. to 125 ft., From 135 ft. to 380 ft.

6 GROUT MATERIAL: 1 Neat cement 2 Cement grout 3 Bentonite 4 Other
 Grout Intervals: From 0 ft. to 2 ft., From 2 ft. to 22 ft., From 125 ft. to 135 ft.

What is the nearest source of possible contamination:
 1 Septic tank 4 Lateral lines 7 Pit privy 10 Livestock pens 14 Abandoned water well
 2 Sewer lines 5 Cess pool 8 Sewage lagoon 11 Fuel storage 15 Oil well/Gas well
 3 Watertight sewer lines 6 Seepage pit 9 Feedyard 12 Fertilizer storage 16 Other (specify below)
 13 Insecticide storage
 Direction from well? Northeast How many feet? 120

FROM	TO	LITHOLOGIC LOG	FROM	TO	PLUGGING INTERVALS
0	5	Backfill - Surface .98 cu. ft of backfill			
5	7	Neat cement .39 cu. ft of neat cement			
7	25	Bentonite grout 3.53 cu. ft of bentonite grout			
25	244	Chlorinated gravel 42.99 cu. ft. of chlorinated gravel			
244	254	Bentonite grout 1.96 cu. ft of Bentonite grout			
254	380	Chlorinated gravel 24.73 cu. ft. of chlorinated gravel			

7 CONTRACTOR'S OR LANDOWNER'S CERTIFICATION: This water well was (1) constructed, (2) reconstructed, or (3) plugged under my jurisdiction and was completed on (mo/day/year) 7-5-89 and this record is true to the best of my knowledge and belief. Kansas Water Well Contractor's License No. 118 This Water Well Record was completed on (mo/day/yr) 7-11-89 under the business name of Carlile Water Well Service, Inc. by (signature)