


1 LOCATION OF WATER WELL:	Fraction	Section Number	Township Number	Range Number
County: Stevens	SE 1/4 NE 1/4 SE 1/4	9	T 31 S	R 35W E/W

Distance and direction from nearest town or city street address of well if located within city? Woods, Kansas - 13 miles North - 1 mile West - 1980' North and 600' West into location.

2 WATER WELL OWNER: Francis Garver  
 RR#, St. Address, Box # : Mobil Oil Corp./ Unit 19  
 City, State, ZIP Code : Phoenix, Arizona Board of Agriculture, Division of Water Resources  
 Application Number: T 87-514

3 LOCATE WELL'S LOCATION WITH AN "X" IN SECTION BOX:

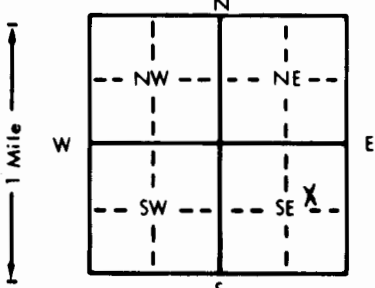

4 DEPTH OF COMPLETED WELL: 440 ft. ELEVATION:

Depth(s) Groundwater Encountered 1. 260 ft. 2. ft. 3. ft.  
 WELL'S STATIC WATER LEVEL: 260 ft. below land surface measured on mo/day/yr  
 Pump test data: Well water was ft. after hours pumping gpm  
 Est. Yield 100 gpm: Well water was ft. after hours pumping gpm  
 Bore Hole Diameter: 11 in. to 440 ft., and in. to ft.  
 WELL WATER TO BE USED AS:  
 5 Public water supply 8 Air conditioning 11 Injection well  
 1 Domestic 3 Feedlot 6 Oil field water supply 9 Dewatering 12 Other (Specify below)  
 2 Irrigation 4 Industrial 7 Lawn and garden only 10 Observation well  
 Was a chemical/bacteriological sample submitted to Department? Yes No X; If yes, mo/day/yr sample was submitted  
 Water Well Disinfected? Yes X No

5 TYPE OF BLANK CASING USED:

1 Steel 3 RMP (SR) 5 Wrought iron 8 Concrete tile CASING JOINTS: Glued Clamped  
 2 PVC 4 ABS 6 Asbestos-Cement 9 Other (specify below) Welded  
 7 Fiberglass Threaded  
 Blank casing diameter 6.625 in. to 3.14 ft., Dia in. to ft., Dia in. to ft.  
 Casing height above land surface 48 in., weight 3.71 lbs./ft. Wall thickness or gauge No. 280

TYPE OF SCREEN OR PERFORATION MATERIAL:

1 Steel 3 Stainless steel 5 Fiberglass 8 RMP (SR) 10 Asbestos-cement  
 2 Brass 4 Galvanized steel 6 Concrete tile 9 ABS 11 Other (specify)  
 12 None used (open hole)  
 SCREEN OR PERFORATION OPENINGS ARE:  
 1 Continuous slot 3 Mill slot 5 Gauzed wrapped 8 Saw cut 11 None (open hole)  
 2 Louvered shutter 4 Key punched 6 Wire wrapped 9 Drilled holes  
 7 Torch cut 10 Other (specify)

SCREEN-PERFORATED INTERVALS: From 320 ft. to 440 ft., From ft. to ft.

GRAVEL PACK INTERVALS: From 260 ft. to 440 ft., From ft. to ft.

6 GROUT MATERIAL: 1 Neat cement 2 Cement grout 3 Bentonite 4 Other

Grout Intervals: From 4 ft. to 260 ft., From ft. to ft., From ft. to ft.  
 What is the nearest source of possible contamination:  
 1 Septic tank 4 Lateral lines 7 Pit privy 10 Livestock pens 14 Abandoned water well  
 2 Sewer lines 5 Cess pool 8 Sewage lagoon 11 Fuel storage 15 Oil well/Gas well  
 3 Watertight sewer lines 6 Seepage pit 9 Feedyard 12 Fertilizer storage 16 Other (specify below)  
 13 Insecticide storage  
 Direction from well? Northwest How many feet? 200'

FROM	TO	LITHOLOGIC LOG	FROM	TO	LITHOLOGIC LOG
0	4	Clay & Dirt backfill	.79		cu. feet of clay & dirt
4	260	Bentonite Grout	50.25		cu. feet of bentonite grout
260	440	Chlorinated sand	35.33		cu. feet of chlorinated sand

7 CONTRACTOR'S OR LANDOWNER'S CERTIFICATION: This water well was (1) constructed, (2) reconstructed, or (3) plugged under my jurisdiction and was completed on (mo/day/year) 02-18-88 and this record is true to the best of my knowledge and belief. Kansas Water Well Contractor's License No. 119 This Water Well Record was completed on (mo/day/yr) 02-22-88 under the business name of Carlile Water Well Service, Inc. by (signature)