


1 LOCATION OF WATER WELL:	Fraction	Section Number	Township Number	Range Number
County: Stevens	NW 1/4 SW 1/4 SE 1/4	10	T 31 S	R 35 (EW)

Distance and direction from nearest town or city street address of well if located within city? From Woods go 13 miles North 1/2 mi West 660' North & 660' East into location.

2 WATER WELL OWNER: Jane Long Mobil Oil Corp.
 RR#, St. Address, Box #: 2802 Cordry Board of Agriculture, Division of Water Resources
 City, State, ZIP Code: Boulder, Colorado 80303 Application Number: T 87-101

3 LOCATE WELL'S LOCATION WITH AN "X" IN SECTION BOX:

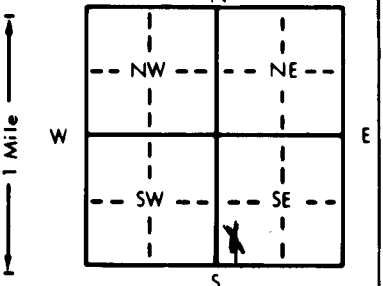

4 DEPTH OF COMPLETED WELL... 440... ft. ELEVATION: ...
 Depth(s) Groundwater Encountered 1... 158... ft. 2... ft. 3... ft.
 WELL'S STATIC WATER LEVEL .. 282... ft. below land surface measured on mo/day/yr ... 3/17/87...
 Pump test data: Well water was ... ft. after ... hours pumping ... gpm
 Est. Yield 100 ... gpm: Well water was ... ft. after ... hours pumping ... gpm
 Bore Hole Diameter... 11... in. to ... 440... ft., and... in. to ... ft.
 WELL WATER TO BE USED AS: 5 Public water supply 8 Air conditioning 11 Injection well
 1 Domestic 3 Feedlot 6 Oil field water supply 9 Dewatering 12 Other (Specify below)
 2 Irrigation 4 Industrial 7 Lawn and garden only 10 Observation well
 Was a chemical/bacteriological sample submitted to Department? Yes.....No.....; If yes, mo/day/yr sample was submitted
 Water Well Disinfected? Yes No

5 TYPE OF BLANK CASING USED:

1 Steel	3 RMP (SR)	5 Wrought iron	8 Concrete tile	CASING JOINTS: Glued	Clamped
2 PVC	4 ABS	6 Asbestos-Cement	9 Other (specify below)	Welded	
		7 Fiberglass		Threaded	

Blank casing diameter ... in. to ... ft., Dia ... in. to ... ft., Dia ... in. to ... ft.
 Casing height above land surface ... in., weight ... lbs./ft. Wall thickness or gauge No. ...

TYPE OF SCREEN OR PERFORATION MATERIAL:

1 Steel	3 Stainless steel	5 Fiberglass	7 PVC	10 Asbestos-cement
2 Brass	4 Galvanized steel	6 Concrete tile	8 RMP (SR)	11 Other (specify)
			9 ABS	12 None used (open hole)

SCREEN OR PERFORATION OPENINGS ARE:

1 Continuous slot	3 Mill slot	5 Gauzed wrapped	8 Saw cut	11 None (open hole)
2 Louvered shutter	4 Key punched	6 Wire wrapped	9 Drilled holes	
		7 Torch cut	10 Other (specify)	

SCREEN-PERFORATED INTERVALS: From ... ft. to ... ft., From ... ft. to ... ft.
 GRAVEL PACK INTERVALS: From ... ft. to ... ft., From ... ft. to ... ft.

6 GROUT MATERIAL: 1 Neat cement 2 Cement grout 3 Bentonite 4 Other ...
 Grout intervals: From ... ft. to ... ft., From ... ft. to ... ft., From ... ft. to ... ft.

What is the nearest source of possible contamination:

1 Septic tank	4 Lateral lines	7 Pit privy	10 Livestock pens	14 Abandoned water well
2 Sewer lines	5 Cess pool	8 Sewage lagoon	11 Fuel storage	15 Oil well/Gas well
3 Watertight sewer lines	6 Seepage pit	9 Feedyard	12 Fertilizer storage	16 Other (specify below)
			13 Insecticide storage	

Direction from well? How many feet?

FROM	TO	LITHOLOGIC LOG	FROM	TO	LITHOLOGIC LOG
		Log for plugging water well			
0	4	dirt .79 cu. feet of dirt			
4	9	cement .98 cu. feet of cement			
9	25	bentonite grout 3.14 cu. feet of grout			
25	280	chlorinated sand 50.06 cu. feet of sand			
280	290	bentonite grout 1.96 cu. feet of grout			
290	440	chlorinated sand 29.45 cu. feet of sand			

7 CONTRACTOR'S OR LANDOWNER'S CERTIFICATION: This water well was (1) constructed, (2) reconstructed, or (3) plugged under my jurisdiction and was completed on (mo/day/year) ... June 5, 1987... and this record is true to the best of my knowledge and belief. Kansas Water Well Contractor's License No. ... 118... This Water Well Record was completed on (mo/day/yr) ... June 10, 1987... under the business name of Carlile Water Well Service, Inc. by (signature)

OFFICE USE ONLY

T

R

EW

SEC.

1/4

1/4

1/4