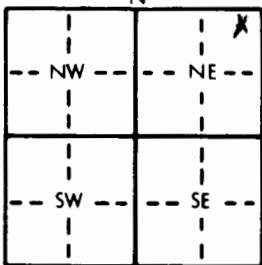


1 LOCATION OF WATER WELL:	Fraction	Section Number	Township Number	Range Number
County: Stevens	NE 1/4 NE 1/4 NE 1/4	23	T 31 S	R 35 E (W)

Distance and direction from nearest town or city street address of well if located within city? **Woods, Kansas north 12 mi. 3/4 E**

660' south into location


2 WATER WELL OWNER: Garry Roland	Sweetman Drlg./McCoy Petrol.
RR#, St. Address, Box # :	Board of Agriculture, Division of Water Resources
City, State, ZIP Code : Moscow, Kansas 67952	Application Number: T89-162

3 LOCATE WELL'S LOCATION WITH AN "X" IN SECTION BOX:	4 DEPTH OF COMPLETED WELL 380 ft. ELEVATION:
	Depth(s) Groundwater Encountered 1. 178 ft. 2. ft. 3. ft.
	WELL'S STATIC WATER LEVEL 193 ft. below land surface measured on mo/day/yr
	Pump test data: Well water was ft. after hours pumping gpm
	Est. Yield 100 gpm: Well water was ft. after hours pumping gpm
	Bore Hole Diameter 11 in. to 380 ft., and in. to ft.
	WELL WATER TO BE USED AS: 5 Public water supply 8 Air conditioning 11 Injection well
	1 Domestic 3 Feedlot 6 Oil field water supply 9 Dewatering 12 Other (Specify below)
	2 Irrigation 4 Industrial 7 Lawn and garden only 10 Monitoring well
	Was a chemical/bacteriological sample submitted to Department? Yes No X ; If yes, mo/day/yr sample was submitted
	Water Well Disinfected? Yes X No

5 TYPE OF BLANK CASING USED:	5 Wrought iron	8 Concrete tile	CASING JOINTS: Glued X Clamped
1 Steel	3 RMP (SR)	6 Asbestos-Cement	9 Other (specify below)
2 PVC	4 ABS	7 Fiberglass	10 Asbestos-cement
Blank casing diameter 6 in. to 240 ft., Dia			11 Other (specify)
Casing height above land surface 30 in., weight lbs./ft. Wall thickness or gauge No.			12 None used (open hole)
TYPE OF SCREEN OR PERFORATION MATERIAL:			
1 Steel	3 Stainless steel	5 Fiberglass	8 RMP (SR)
2 Brass	4 Galvanized steel	6 Concrete tile	9 ABS
SCREEN OR PERFORATION OPENINGS ARE:			
1 Continuous slot	3 Mill slot	5 Gauzed wrapped	8 Saw cut
2 Louvered shutter	4 Key punched	6 Wire wrapped	9 Drilled holes
SCREEN-PERFORATED INTERVALS:			
From 220 ft. to 340 ft., From 360 ft. to 380 ft.			
GRAVEL PACK INTERVALS:			
From 27 ft. to 50 ft., From 60 ft. to 380 ft.			

6 GROUT MATERIAL:	Neat cement	2 Cement grout	3 Bentonite	4 Other
Grout Intervals: From ft. to ft., From ft. to ft., From ft. to ft.				
What is the nearest source of possible contamination:				
1 Septic tank	4 Lateral lines	7 Pit privy	10 Livestock pens	14 Abandoned water well
2 Sewer lines	5 Cess pool	8 Sewage lagoon	11 Fuel storage	15 Oil well/Gas well
3 Watertight sewer lines	6 Seepage pit	9 Feedyard	12 Fertilizer storage	16 Other (specify below)
Direction from well? West				

FROM	TO	LITHOLOGIC LOG	FROM	TO	PLUGGING INTERVALS
0	2	Surface			
2	42	Sandy clay			
42	57	Clay			
57-	62	Sandy clay			
62	116	Med. to large sand			
116	120	Gravel			
120	140	Med. to large sand			
140	283	15% clay-85% Med. to large sand			
283	298	50% clay-50% Med. to large sand			
298-318		80% Clay-20% Med. to large sand			
318	350	50% Clay-50% Med. to large sand			
350	360	Clay			
360	380	50% Clay-50% Med. to large sand			

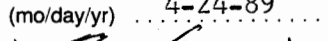7 CONTRACTOR'S OR LANDOWNER'S CERTIFICATION: This water well was (1) constructed , (2) reconstructed, or (3) plugged under my jurisdiction and was completed on (mo/day/year) 4-11-89 and this record is true to the best of my knowledge and belief. Kansas Water Well Contractor's License No. 118 This Water Well Record was completed on (mo/day/yr) 4-24-89 under the business name of Carlile Water Well Service, Inc. by (signature) 
--